# TOWNSHIP 24 SOUTH, RANGE 7 WEST, OF THE WILLAMETTE MERIDIAN, OREGON.

## DEPENDENT RESURVEY AND SUBDIVISION OF SECTION 33

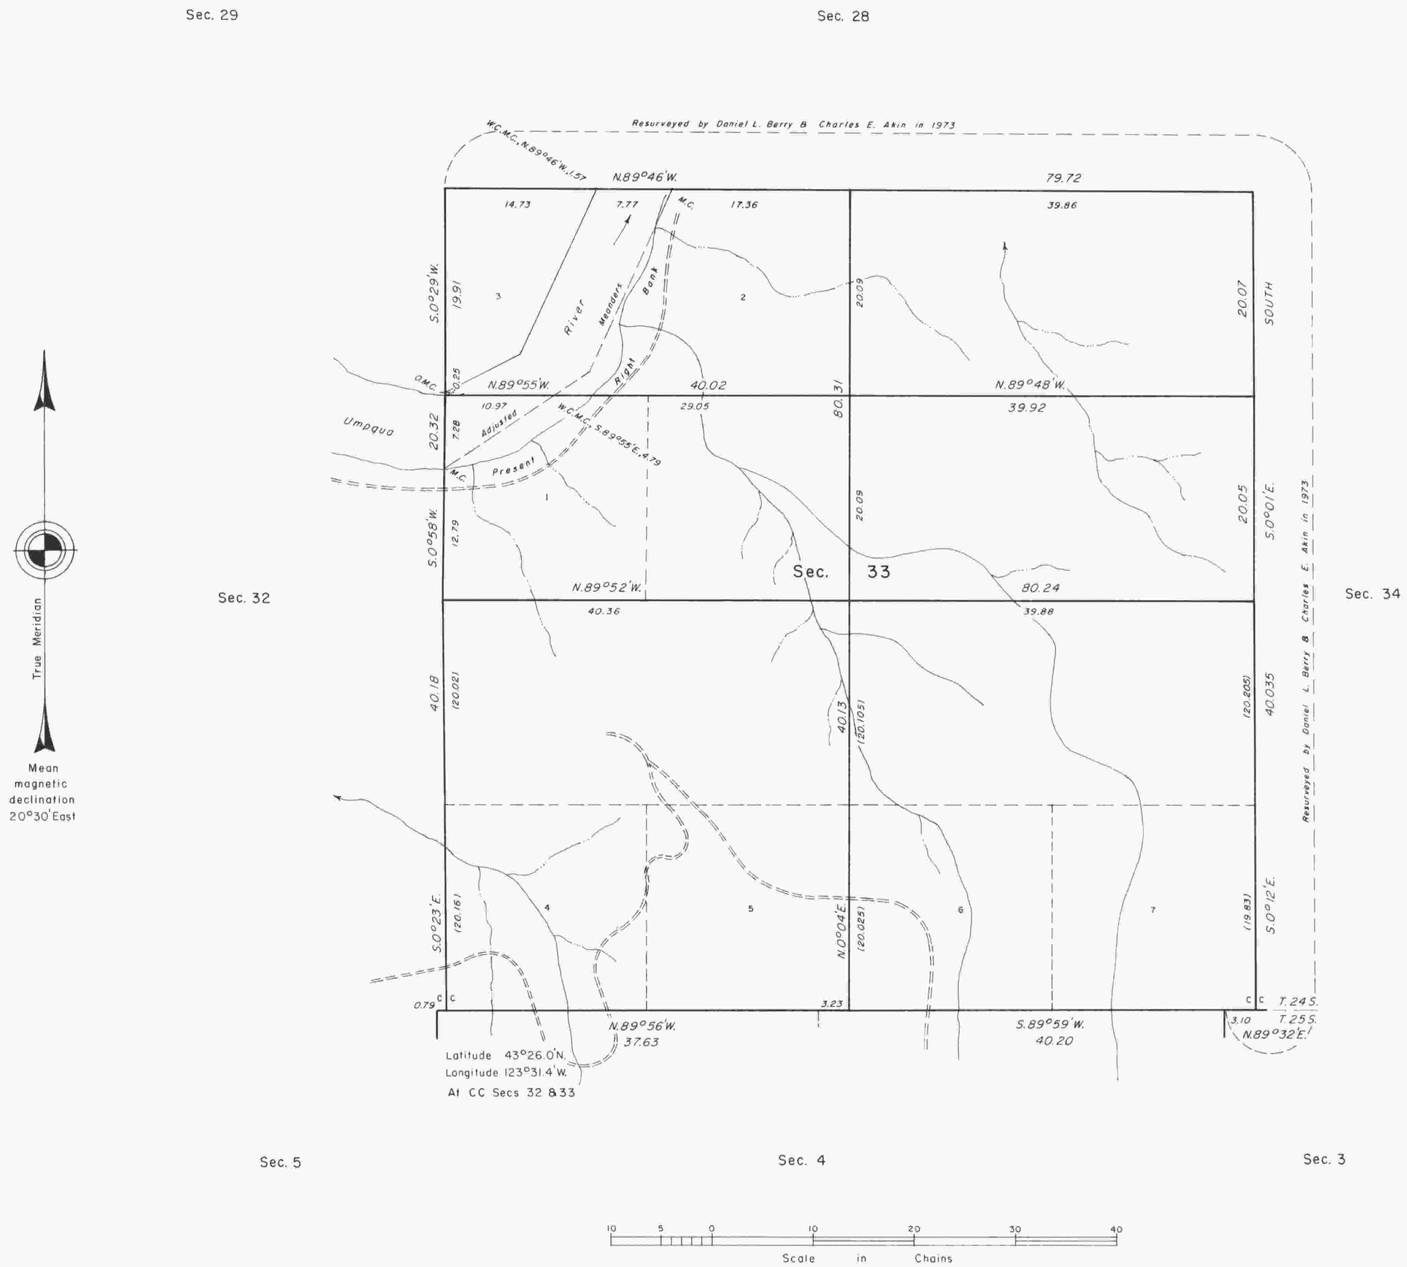


A history of surveys is contained in the field notes.

This plat represents a dependent resurvey of a portion of the south boundary and subdivisional lines, T. 24 S., R. 7 W., Willamette Meridian, Oregon, designed to restore the corners in their true original locations according to the best available evidence, and the subdivision of section 33.

Except as shown hereon, the lottings and areas are as shown on the plats approved April 24, 1858, October 22, 1860, and June 27, 1895.

The survey was executed by James E. Jelley and Wayne L. Rogers, Cadastral Surveyors, beginning October 2, 1979 and completed November 9, 1979, pursuant to Special Instructions for Group No. 998, Oregon, dated September 27, 1979.

Timber in this area consists of fir, hemlock, cedar, maple, oak, madrone, yew, chinquapin, and alder.

UNITED STATES DEPARTMENT OF THE INTERIOR
BUREAU OF LAND MANAGEMENT
Portland, Oregon January 26, 1983

This plat is strictly conformable to the approved field notes, and the survey, having been correctly executed in accordance with the requirements of law and the regulations of this Bureau, is hereby accepted.

For the Director

William W. Glenn

Chief Cadastral Surveyor of Oregon

rfb