


Township N. 24 South Range N. 8 West Willamette Meridian.

1112

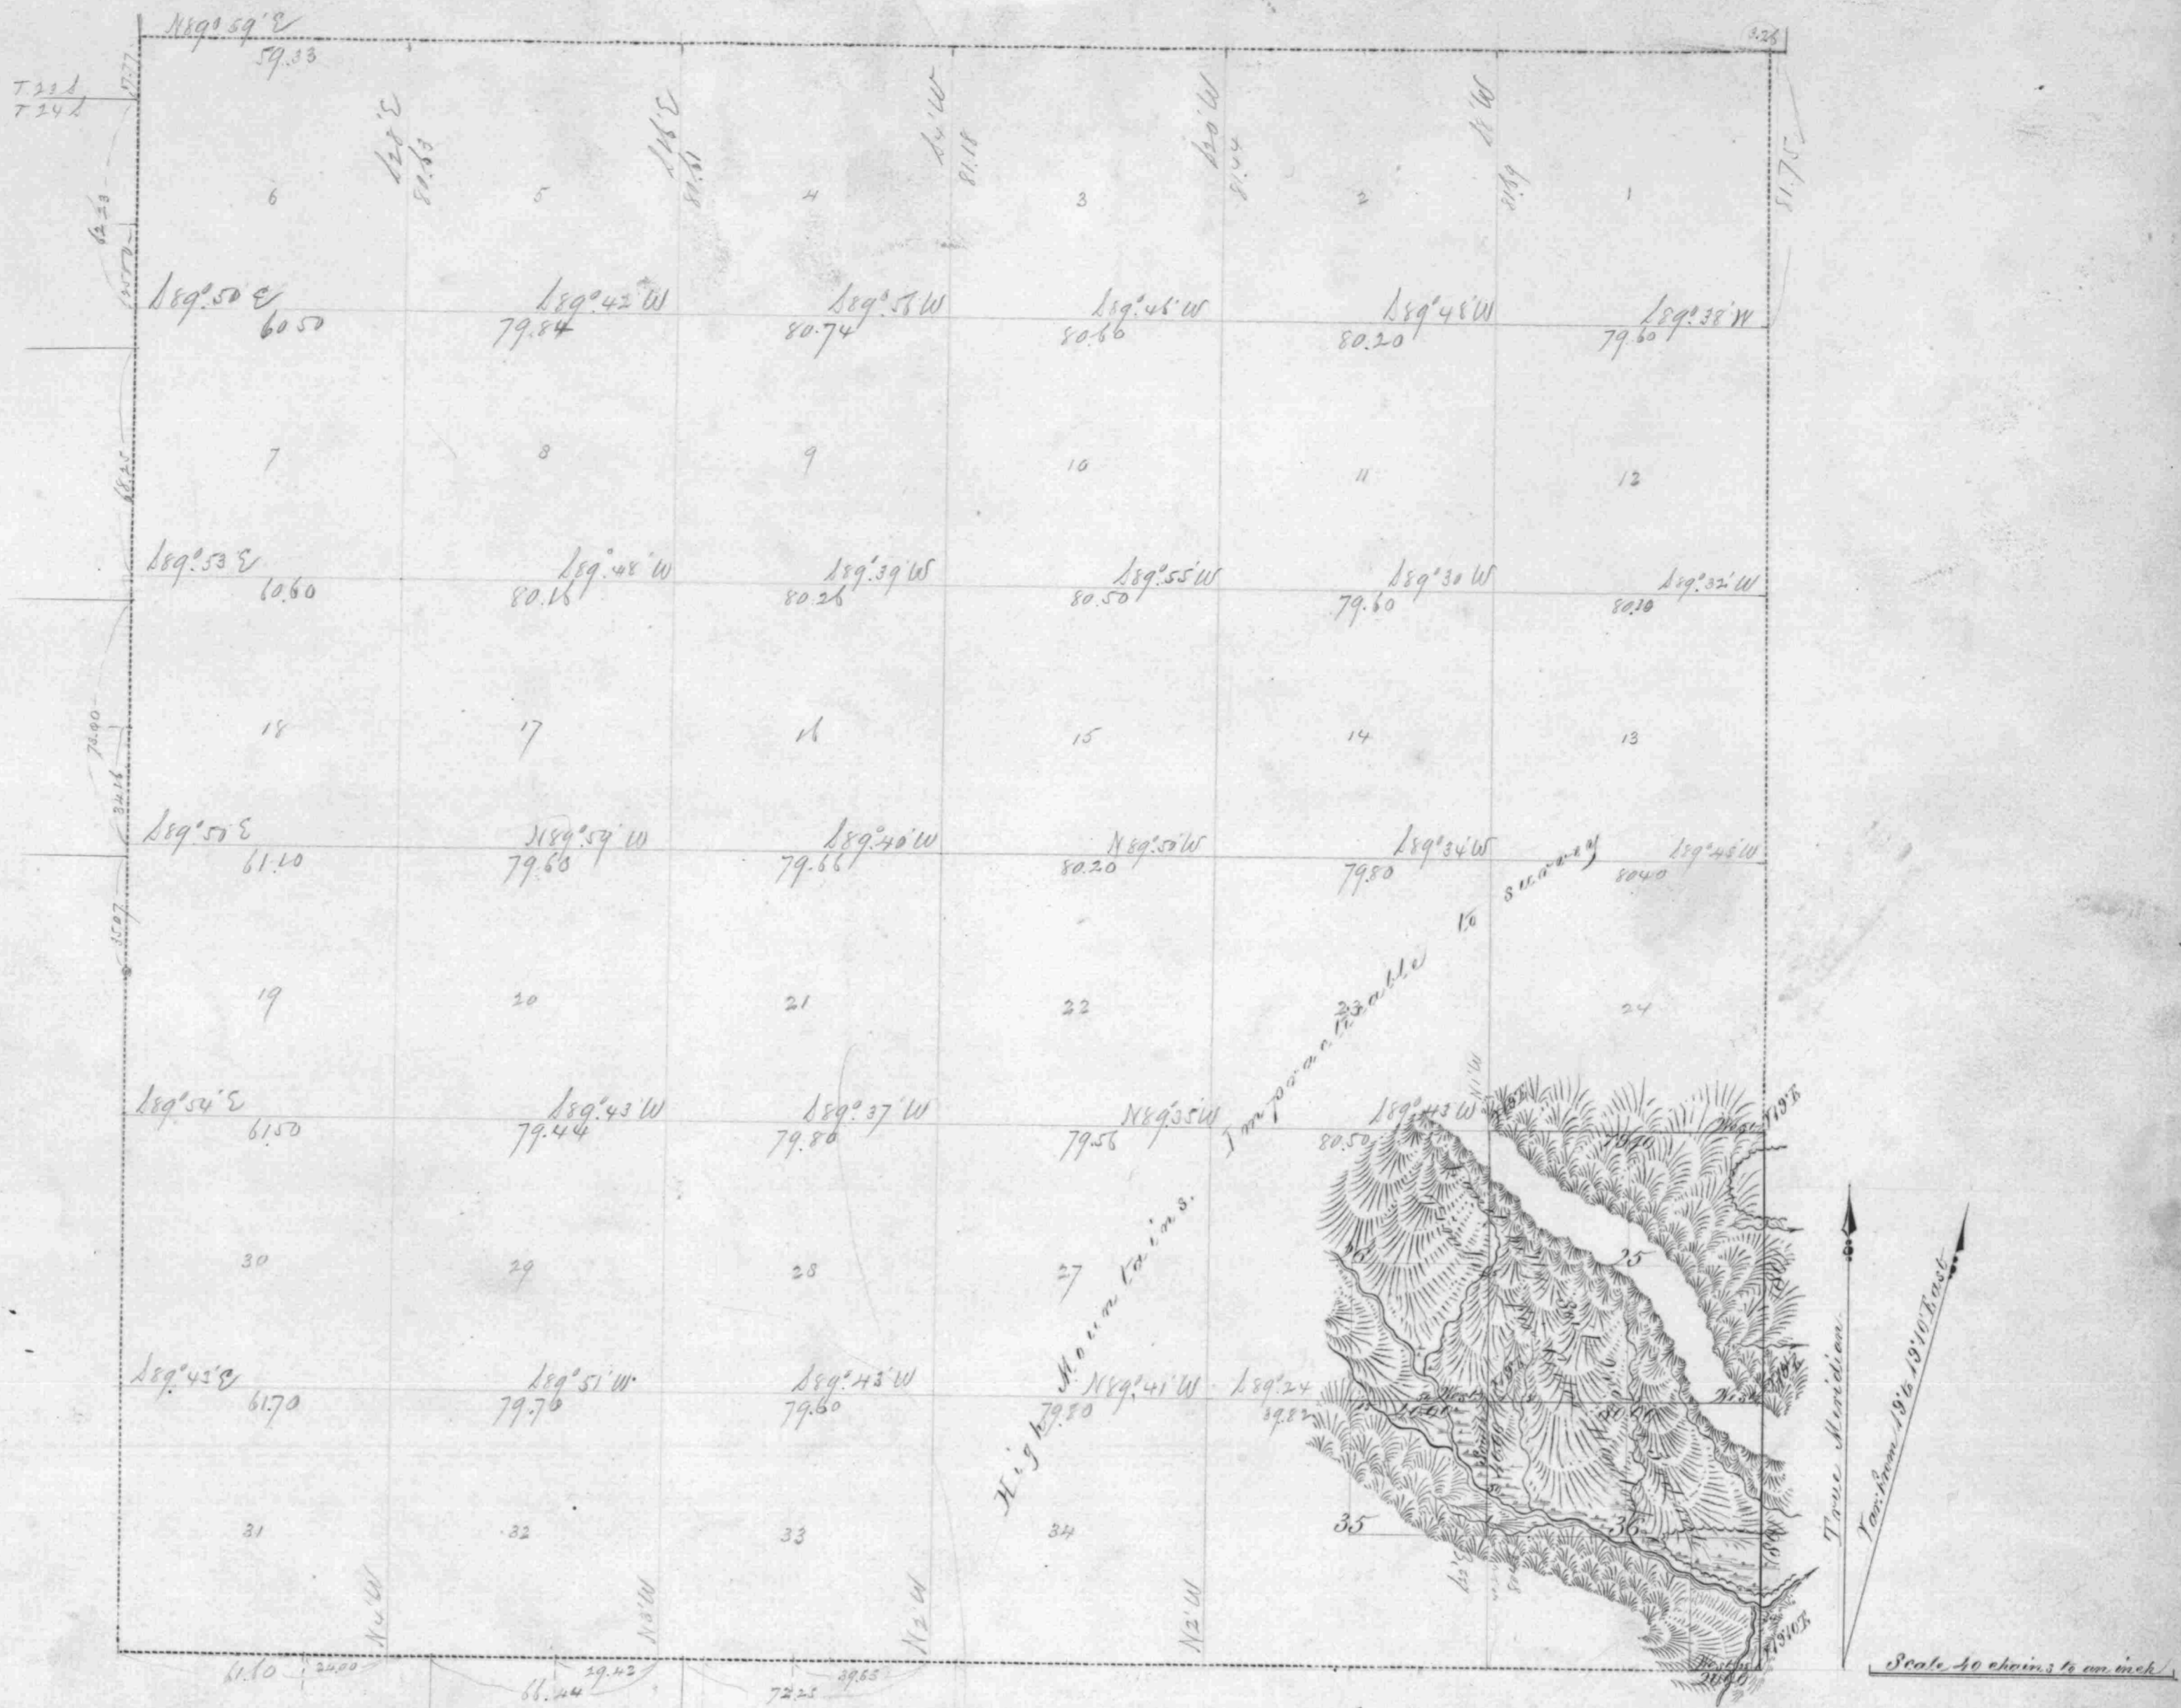

Surveys designated	By whom surveyed	Contract		Amt of surveys			When surveyed
		No	Date	Acres	chains	links	
Township Lines	Dennis Hathorn	73	June 8th 1857	00	20	00	December 24th 1857
Sub-divisions	Dennis Hathorn	73	June 8th 1857	03	79	40	April 24th 1858
Total number of Acres				1360	00		

The above Map of Fractional Township N. 24 South of Range N. 8 West of the Willamette Meridian, Territory of Oregon is strictly conformable to the field notes of the survey thereof on file in this office which have been examined and approved.

Surveyor General's Office
 Salem, April 24th 1858.

John S. Zieber,
 Sur. Gen. of Oregon