5772

ORIGINAL

TOWNSHIP 25 SOUTH, RANGE 1 WEST, OF THE WILLAMETTE MERIDIAN, OREGON.

DEPENDENT RESURVEY, SUBDIVISION OF SECTIONS, AND REMONUMENTATION

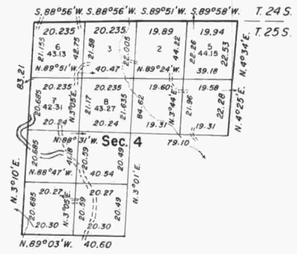

Sec. 5 | Sec. 3

Sec. 9 | Sec. 10 | Sec. 11 | Sec. 12

Sec. 12 | Sec. 18 | Sec. 17 | Sec. 15 | Sec. 14

Sec. 13 | Sec. 19 | Sec. 20 | Sec. 21 | Sec. 22 | Sec. 23

Sec. 24 | Sec. 30 | Sec. 29 | Sec. 28 | Sec. 27 | Sec. 26 | Sec. 25

Sec. 25 | Sec. 31 | Sec. 32 | Sec. 33 | Sec. 35 | Sec. 36

Sec. 36

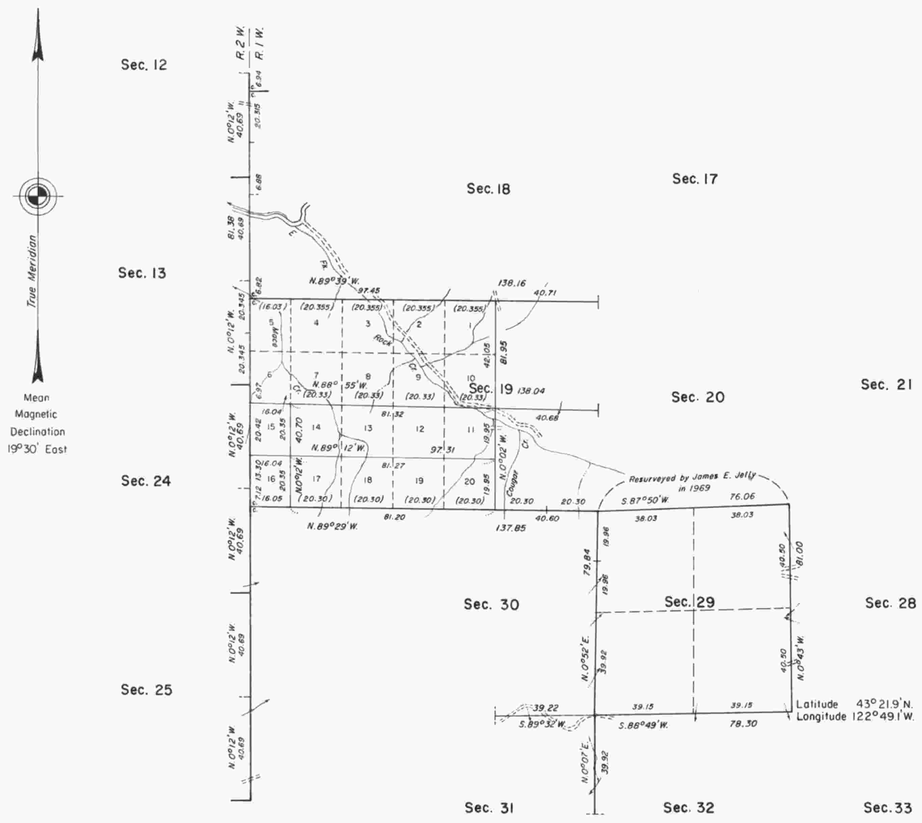

10 0 20 40 60 80
Chains

Timber in this area consists of fir, hemlock, cedar, white fir, pine, maple, alder, chinquapin, madrone, and yew.

R.T.S.

A history of surveys is contained in the field notes.

This plat represents a dependent resurvey of a portion of the east boundary, T. 25 S., R. 2 W., and a portion of the north boundary and subdivisional lines, and the remonumentation of certain original corner points designed to restore the corners in their true original locations according to the best available evidence, and the subdivision of sections 4 and 19, T. 25 S., R. 1 W., Willamette Meridian, Oregon.

Except as indicated hereon, the lottings and areas are as shown on the plat approved May 6, 1901.

Survey and remonumentation executed by James E. Jelley, Cadastral Surveyor, beginning May 4, 1978, and completed May 6, 1980, pursuant to Special Instructions dated May 3, 1957, and February 18, 1977, and Supplemental Special Instructions dated February 1, 1978, for Group Nos. 350 and 929, Oregon.

UNITED STATES DEPARTMENT OF THE INTERIOR
BUREAU OF LAND MANAGEMENT
Denver, Colorado May 14, 1981

This plat is strictly conformable to the approved field notes, and the survey, having been correctly executed in accordance with the requirements of law and the regulations of this Bureau, is hereby accepted.

For the Director

D. Woodward

Chief, Cadastral Survey
Examination and Approval Staff