


TOWNSHIP N^o 25 SOUTH, RANGE N^o 2 EAST, OF THE WILLAMETTE MERIDIAN, OREGON.

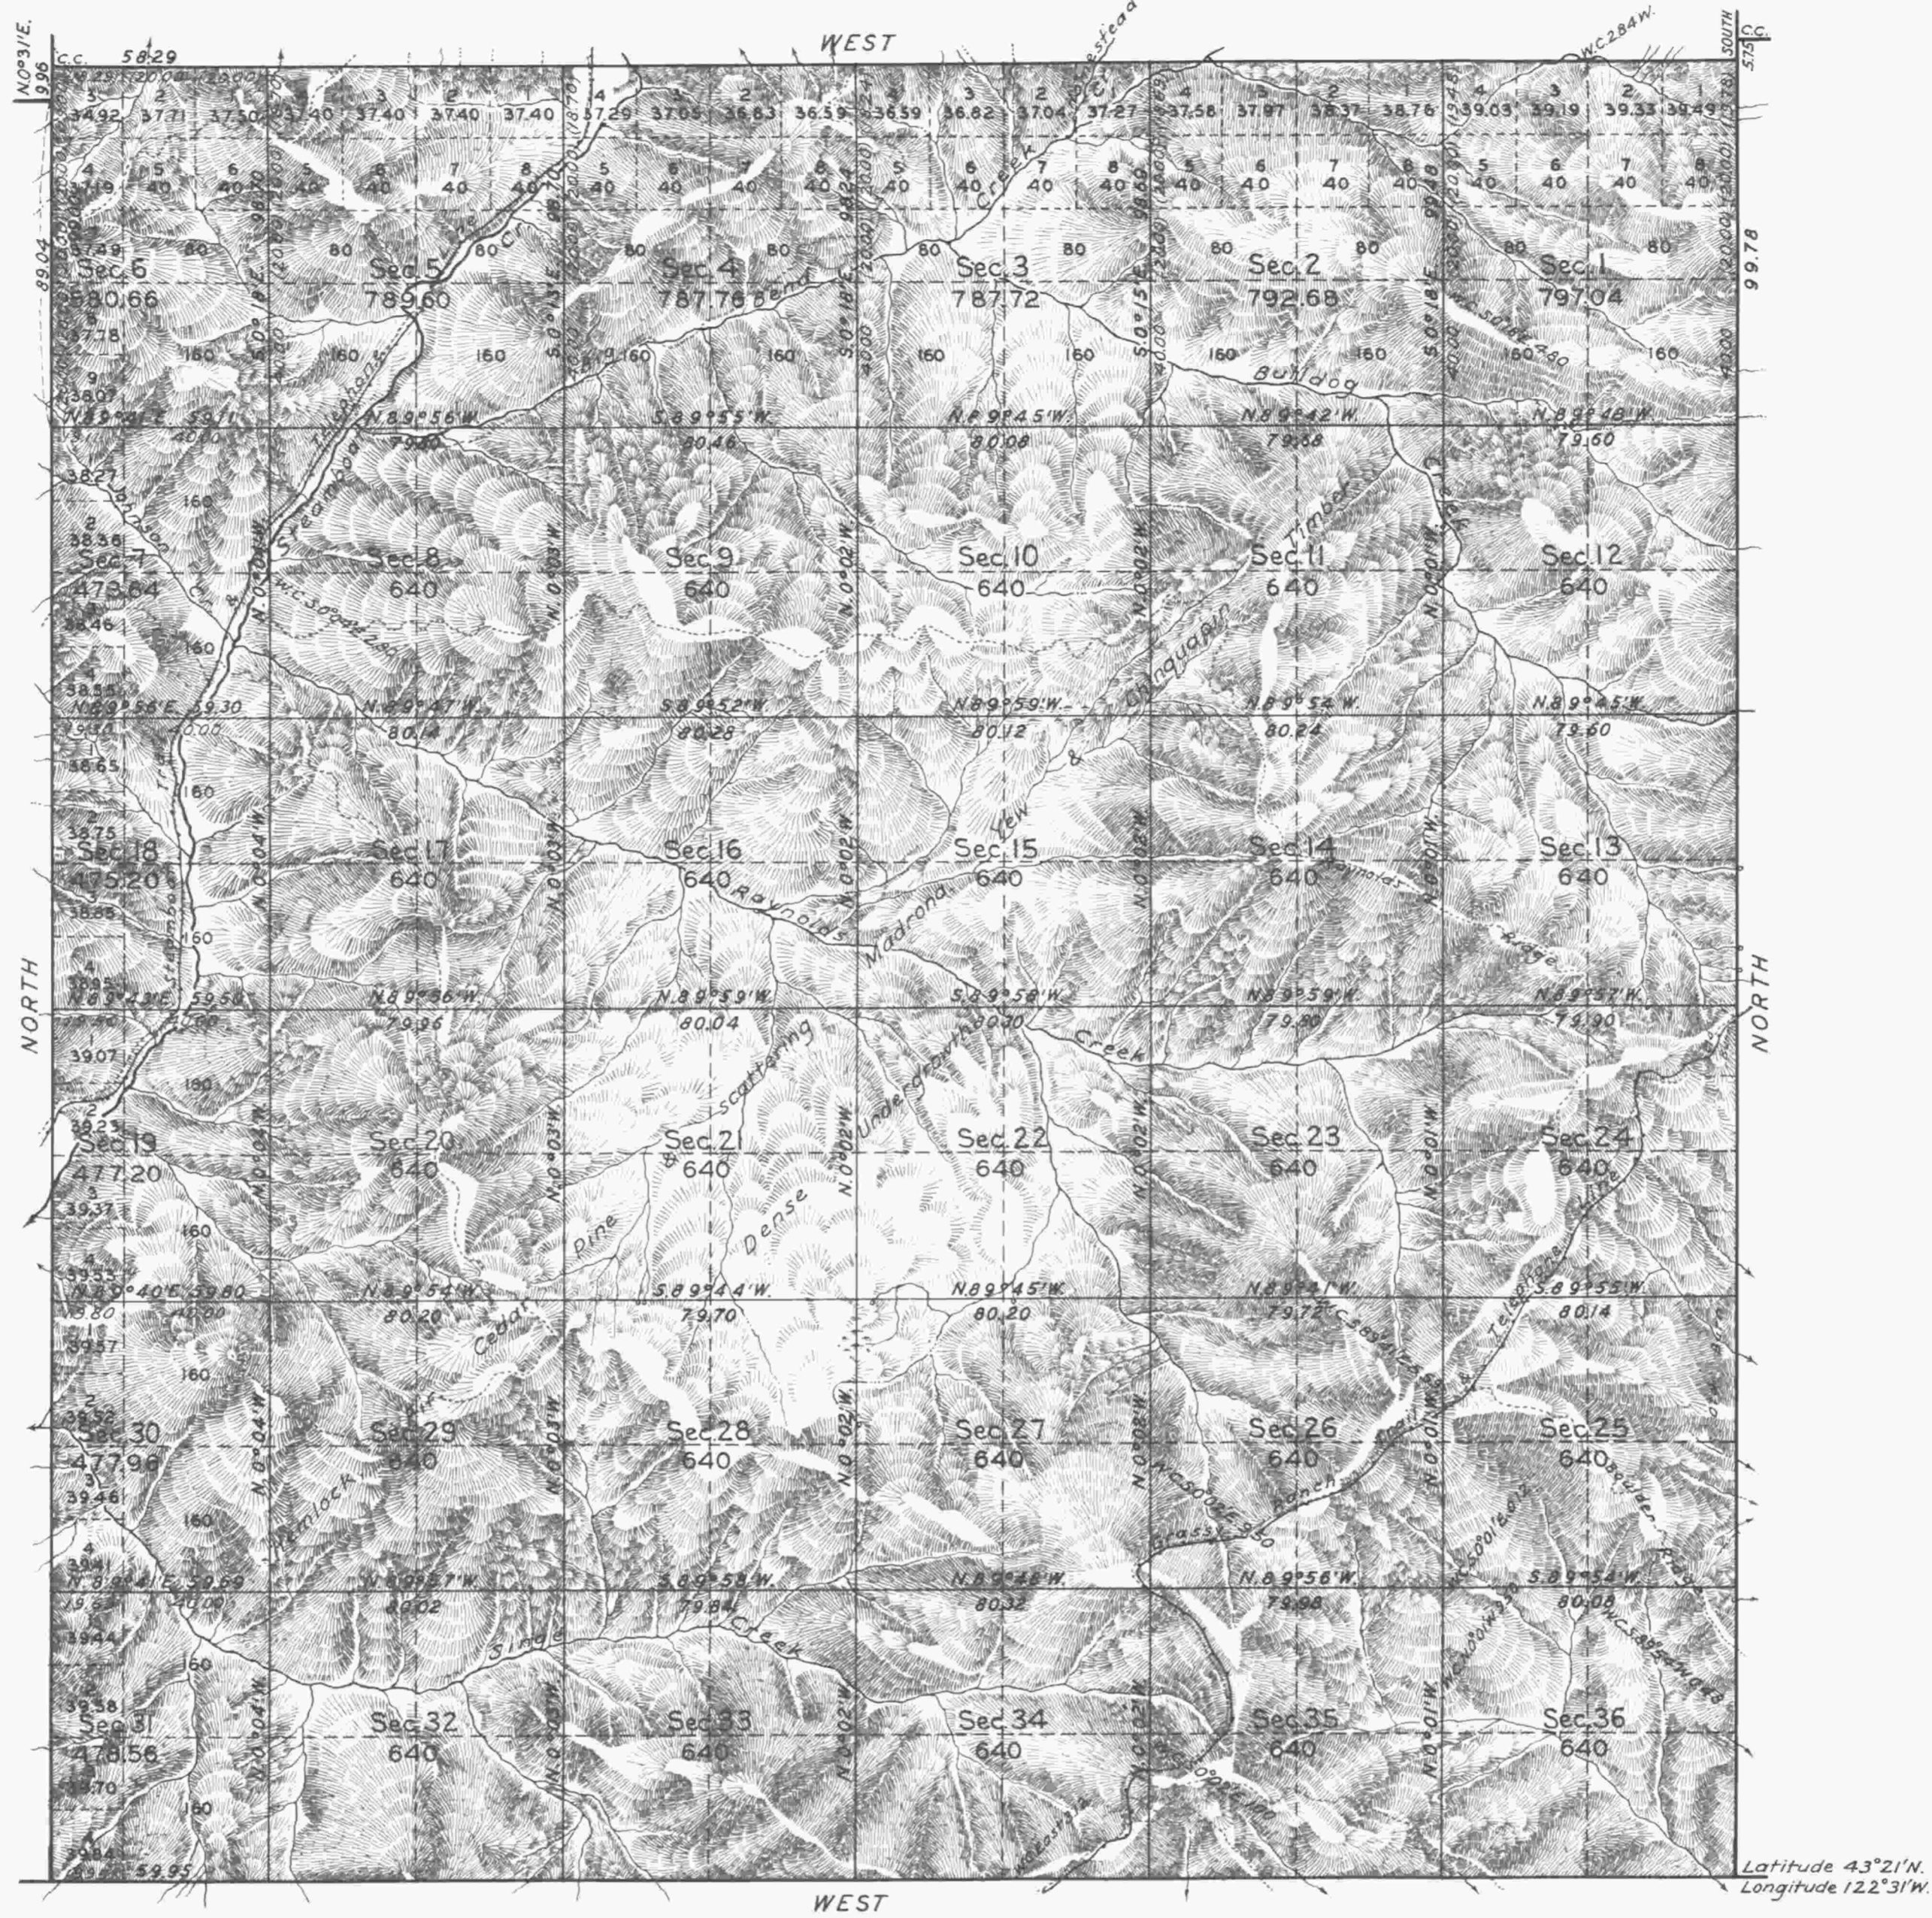

Mean Magnetic Declination 20°E. Scale: 40 Chains to an Inch. Area Surveyed 22,918.02 Acres.

LINES DESIGNATED	BY WHOM SURVEYED	N ^o	GROUP DATE	MILEAGE MLS. CHS.	WHEN BEGUN	SURVEYED COMPLETED
Exterior	John G. Collins			11 79.73	July 7, 1928	July 25, 1928
Subdivisional	" " "	74	March 12, 1921	59 71.41	" 27, "	Aug. 5, 1930
Miscellaneous	& Otto L. Draper					

Office of U.S. Supervisor of Surveys,
Denver, Colorado, July 30, 1931.
The above plat of Township N^o 25 South, Range N^o 2 East, of the Willamette Meridian, Oregon, is strictly conformable to the field notes of the survey thereof which have been examined and approved.

Wm. P. Hanson
U. S. Supervisor of Surveys.

DEPARTMENT OF THE INTERIOR
GENERAL LAND OFFICE
Washington, D. C., Nov 4, 1931

The survey represented by this plat having been correctly executed in accordance with the requirements of law and the regulations of this office, is hereby accepted.

D. K. Carver
Acting Assistant Commissioner.