TOWNSHIP 25 SOUTH, RANGE 2 WEST, OF THE WILLAMETTE MERIDIAN, OREGON

DEPENDENT RESURVEY AND SUBDIVISION OF SECTION 29

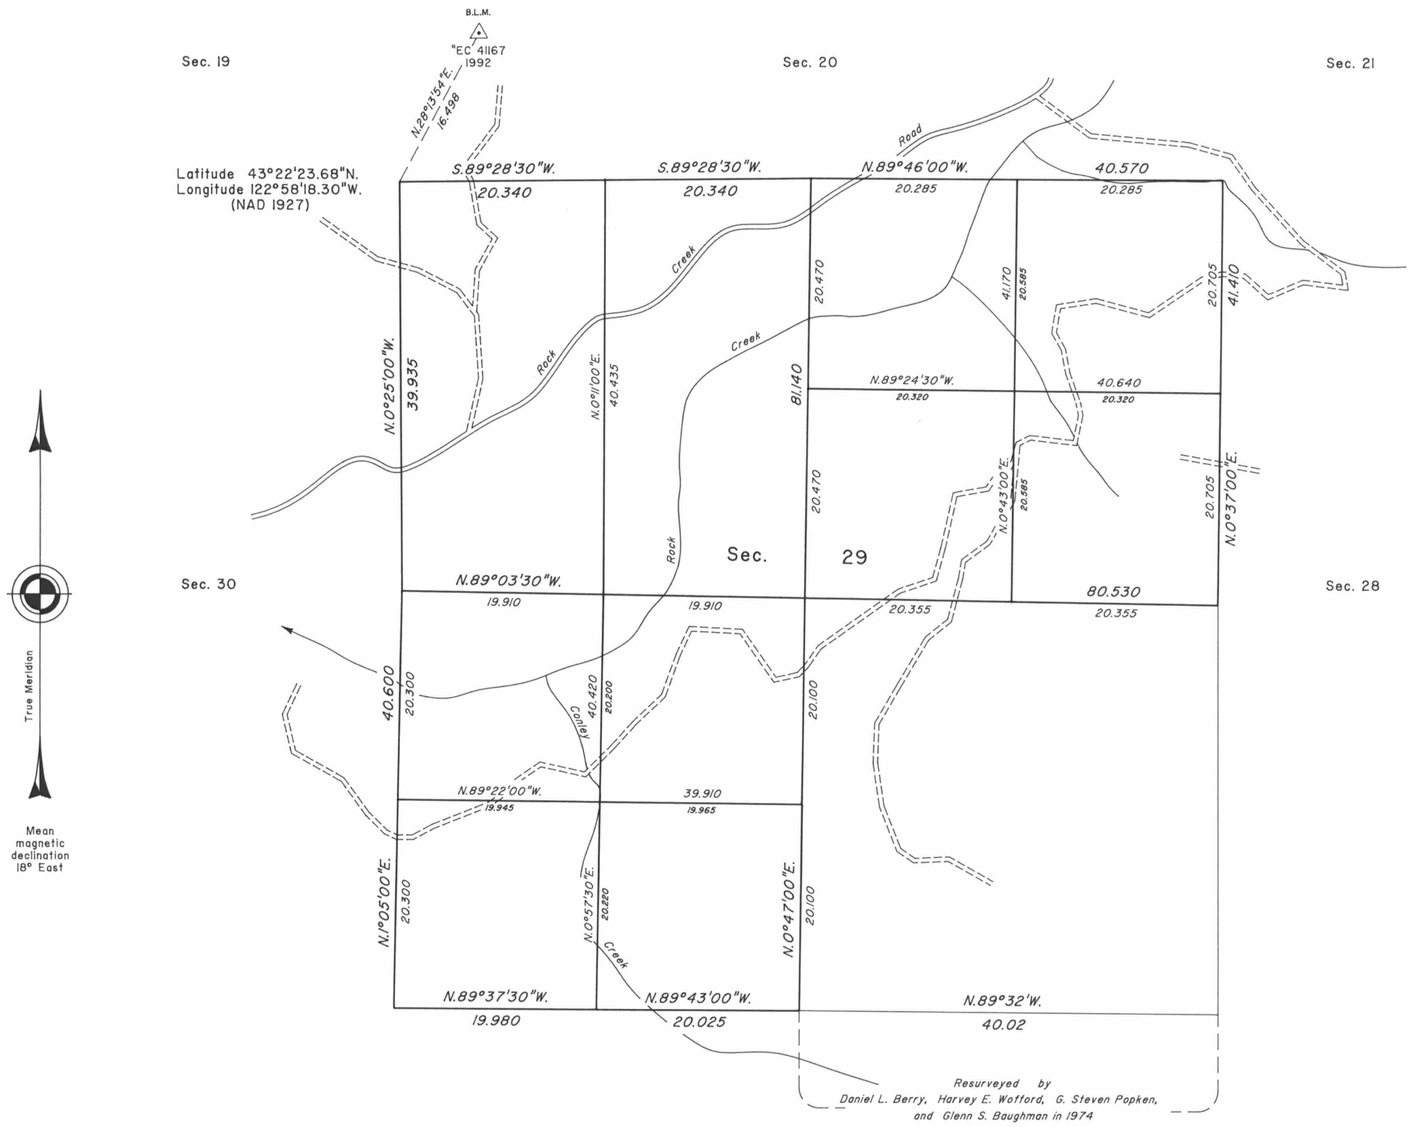

A history of surveys is contained in the field notes.

This plat represents a dependent resurvey of a portion of the subdivisional lines, T. 25 S., R. 2 W., Willamette Meridian, Oregon, designed to restore the corners in their true original locations according to the best available evidence, and the subdivision of section 29.

The lottings and areas are as shown on the plat approved May 6, 1901.

The survey was executed by Wayne L. Rogers, Cadastral Surveyor, and Robert H. Browning, Surveying Technician, beginning June 21, 1993, and completed July 28, 1993, pursuant to Special Instructions dated August 6, 1992, under Group Number 1659, Oregon.

Timber in this area consists of fir, hemlock, cedar, maple, ash, yew, willow, oak, and alder.

The tie to the geodetic control station is reported as mean bearing and sea level distance.

UNITED STATES DEPARTMENT OF THE INTERIOR
BUREAU OF LAND MANAGEMENT

Portland, Oregon November 1, 1995

This plat is strictly conformable to the approved field notes, and the survey, having been correctly executed in accordance with the requirements of law and the regulations of this Bureau, is hereby accepted.

For the Director

Wayne M. Gardner

Chief Cadastral Surveyor of Oregon

R.S.B.