ORIGINAL

TOWNSHIP 25 SOUTH, RANGE 2 WEST, OF THE WILLAMETTE MERIDIAN, OREGON

CORRECTIVE DEPENDENT RESURVEY, DEPENDENT RESURVEY AND SUBDIVISION OF SECTION 34

FILED
Date 10-23-2008 By: JC
This survey consists of:
Map
Narrative VOL 53
Corner Rec Pgs 20-446-65
DOUGLAS COUNTY

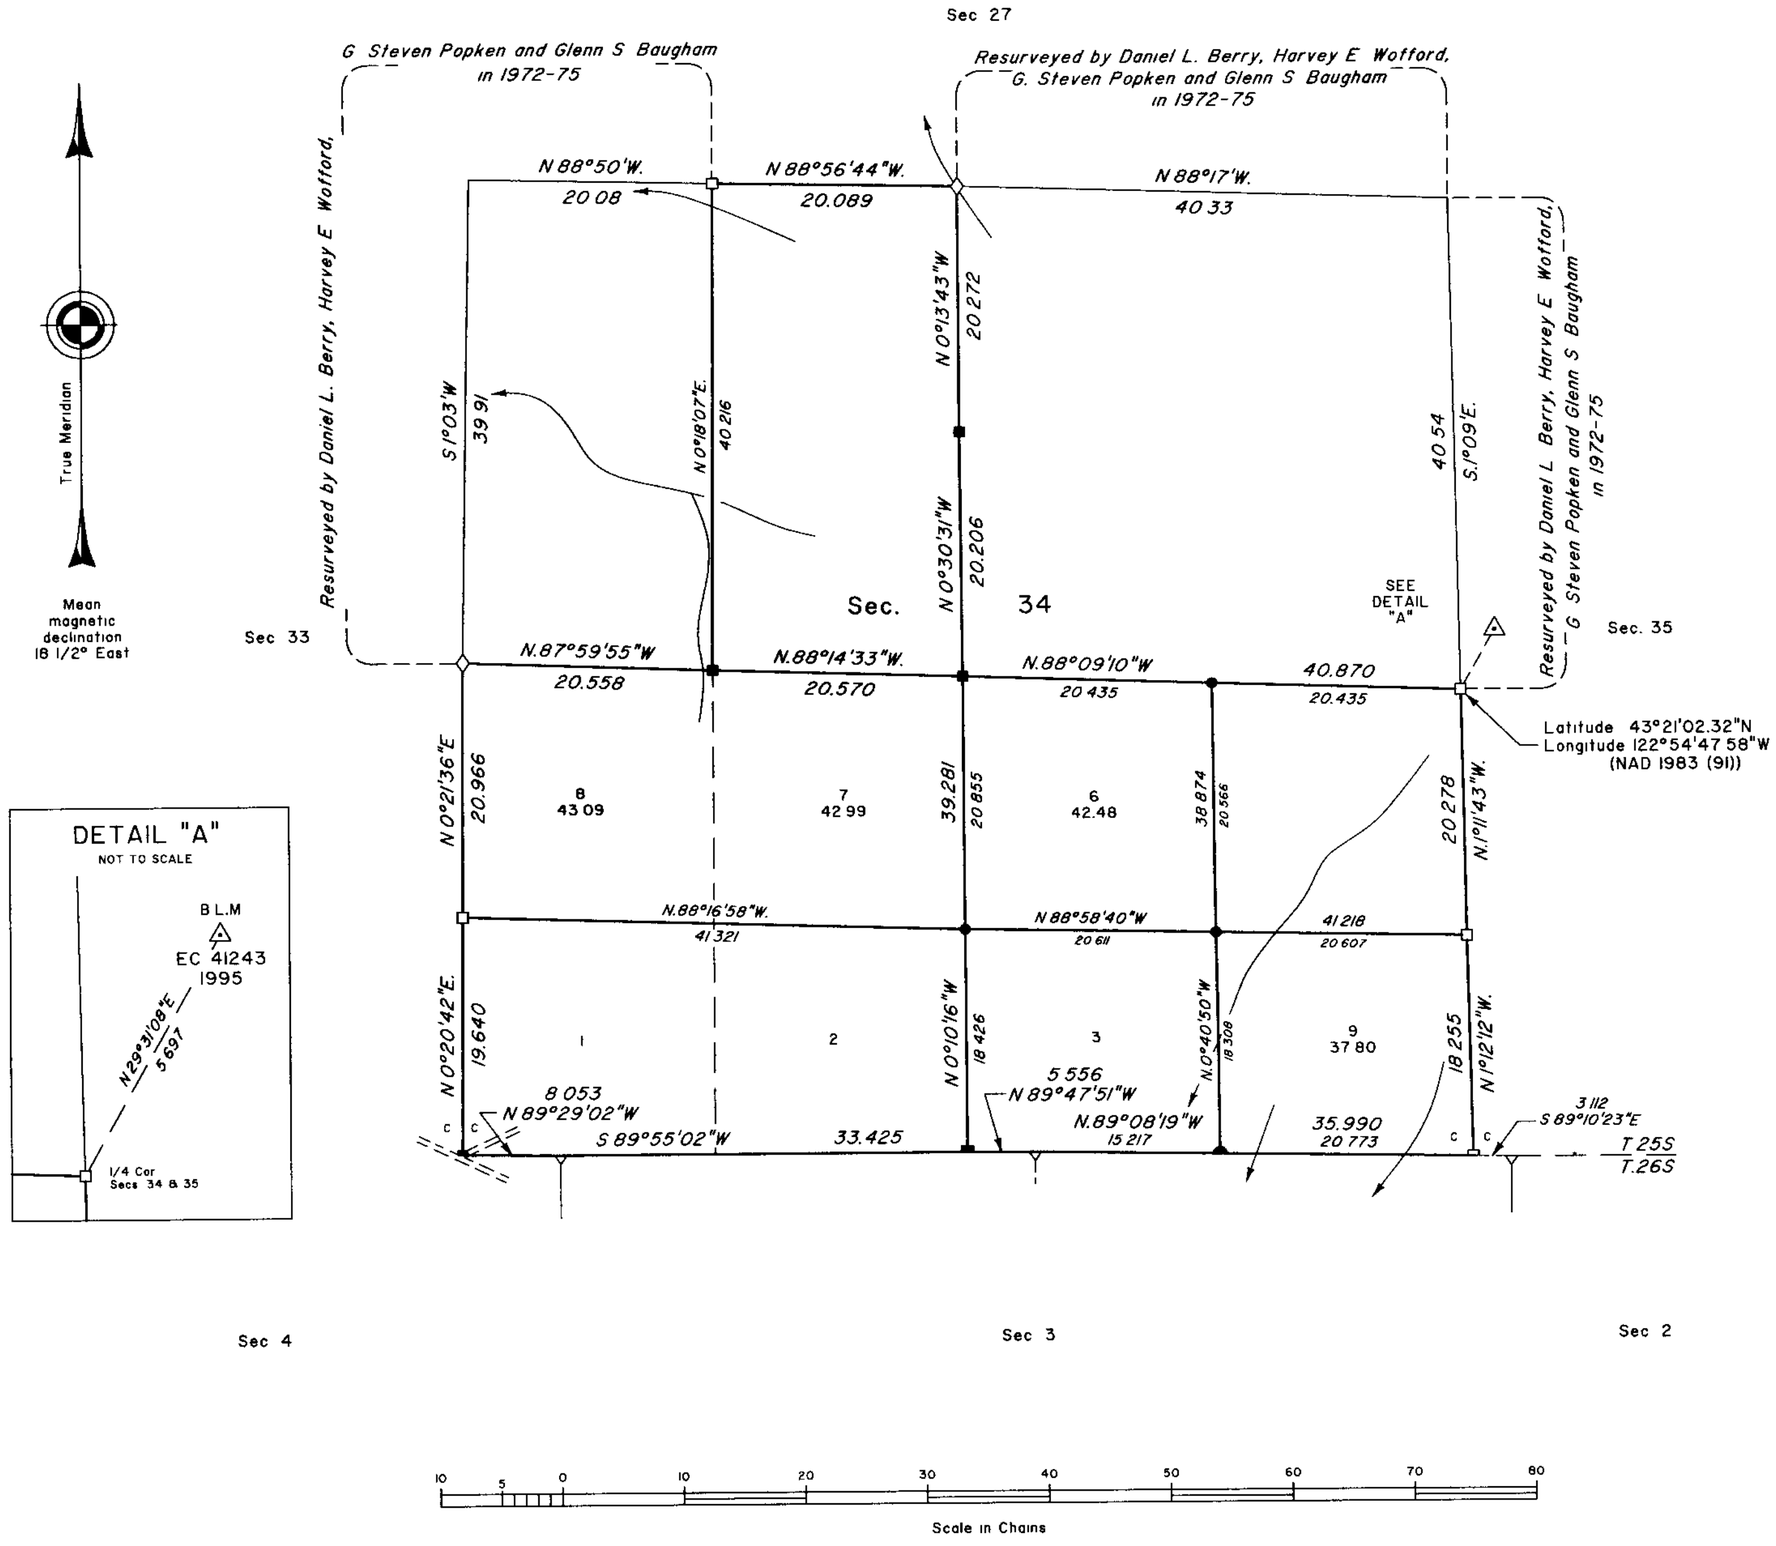

A history of surveys is contained in the field notes

This plat represents a corrective dependent resurvey of a portion of the south boundary, and dependent resurvey of a portion of the subdivisional lines, T. 25 S, R 2 W, Willamette Meridian, Oregon, designed to restore the corners in their true original locations according to the best available evidence, and the subdivision of section 34

Measured distances and directions have been adjusted by Cadastral Measurement Management (CMM), computer software that incorporates a least squares adjustment routine The adjusted bearings and distances are reported to the nearest second and 0.001 chain

Except as shown hereon, the lottings and areas are as shown on the plat approved May 6, 1901

The survey was executed by Bryan S Seibold, Cadastral Surveyor, and Robert H Browning, Surveying Technician, beginning May 8, 1995, and completed July 7, 1998, pursuant to Special Instructions dated April 18, 1995, and Supplemental Special Instructions dated June 22, 1998, under Group Number 1754, Oregon

Timber in this area consists of fir, cedar, hemlock, pine, alder, maple, madrone and oak

The tie to the geodetic control station is reported as mean bearing and sea level distance

LEGEND

- ◇ Original corner previously remonumented
- □ Corner previously established or reestablished
- ■ Corner previously established or reestablished; remonumented this survey
- ● Corner established or reestablished this survey

UNITED STATES DEPARTMENT OF THE INTERIOR
BUREAU OF LAND MANAGEMENT

Portland, Oregon August 4, 2000

This plat is strictly conformable to the approved field notes, and the survey, having been correctly executed in accordance with the requirements of law and the regulations of this Bureau, is hereby accepted

For the Director

Chief Cadastral Surveyor of Oregon

R.F.B