TOWNSHIP 25 SOUTH, RANGE 2 WEST, OF THE WILLAMETTE MERIDIAN, OREGON

DEPENDENT RESURVEY AND SUBDIVISION OF SECTIONS 11 AND 13

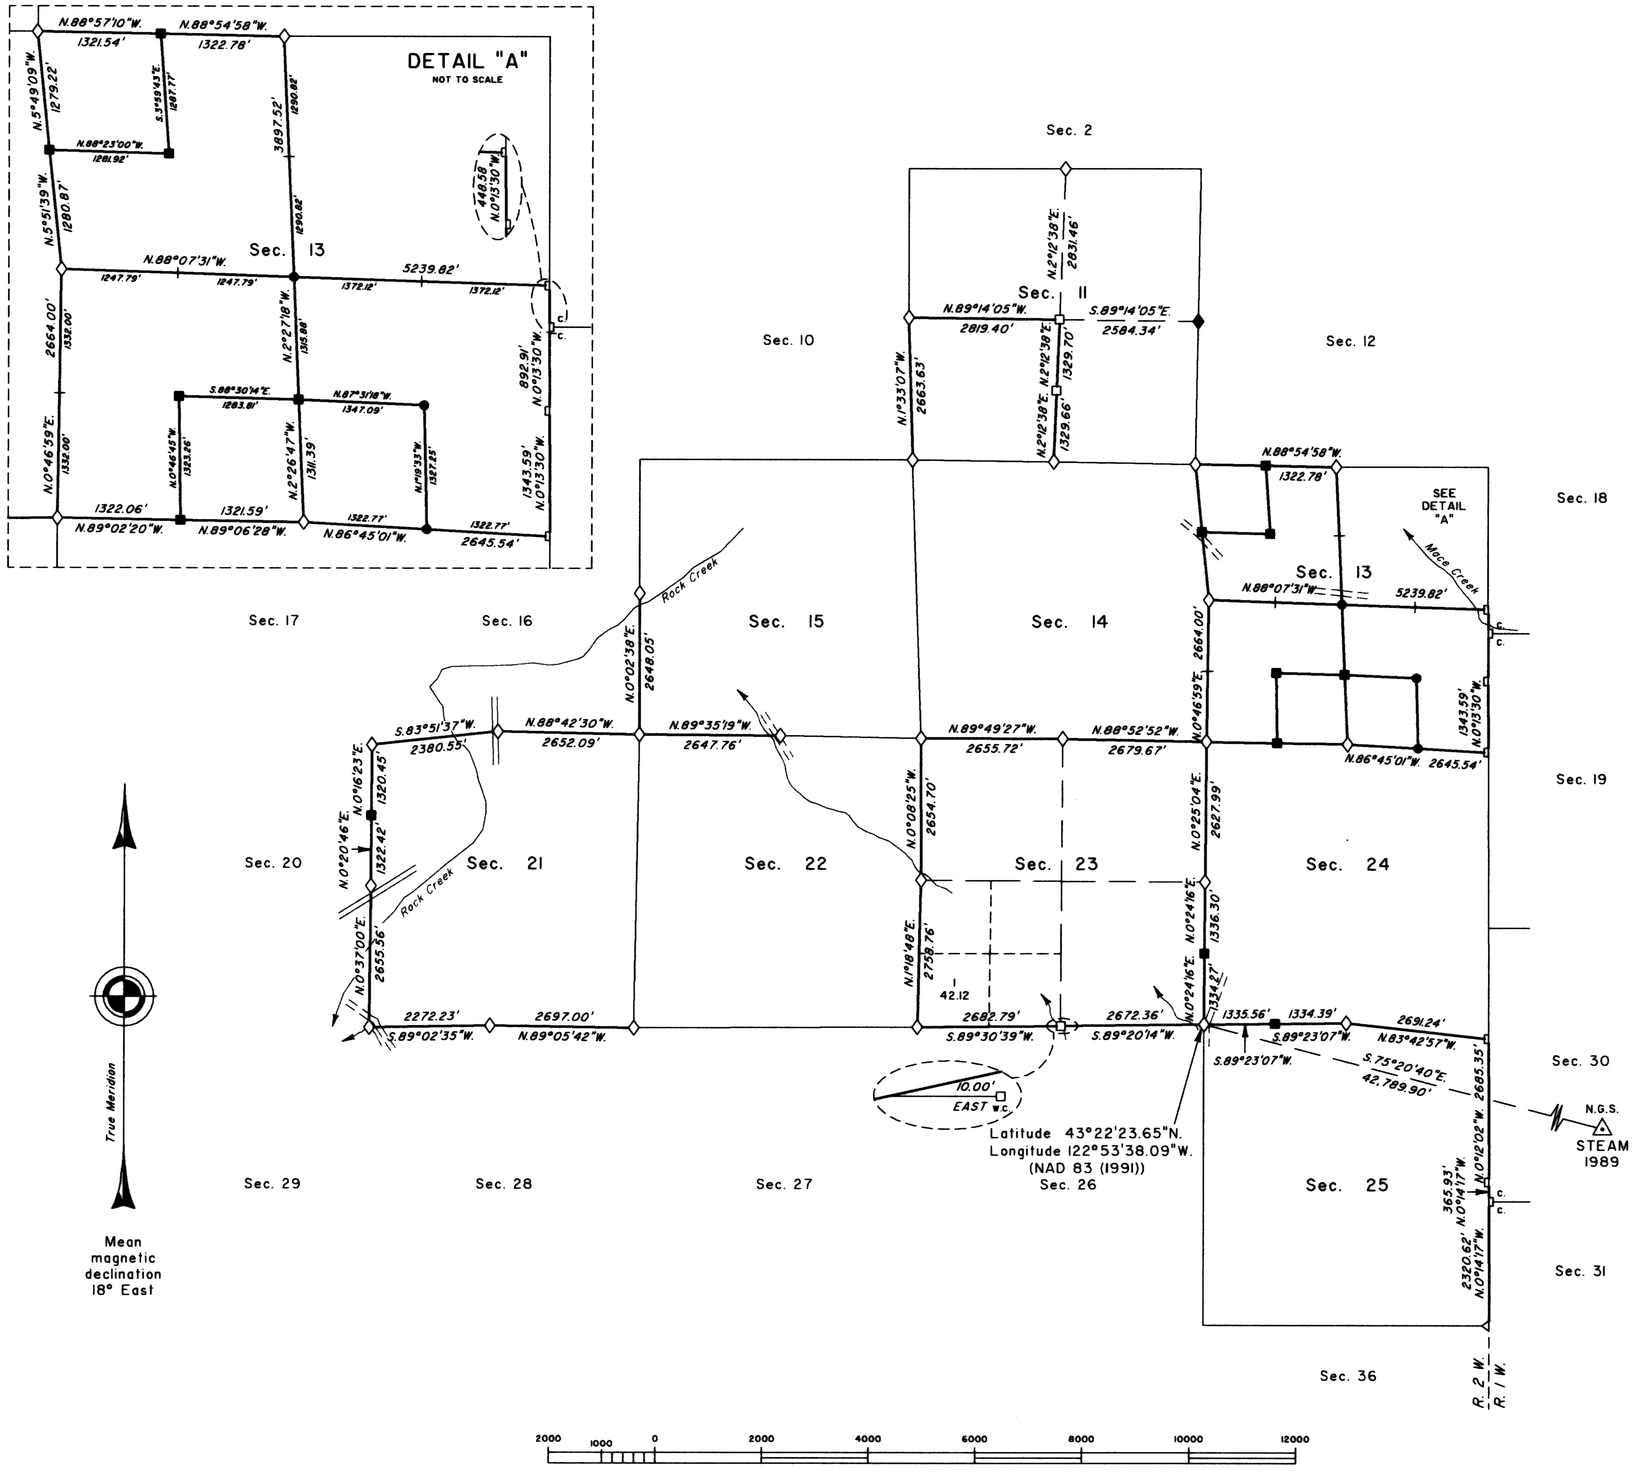

A history of surveys is contained in the field notes.

This plat represents a dependent resurvey of portions of the east boundary and subdivisional lines, T. 25 S., R. 2 W., Willamette Meridian, Oregon, designed to restore the corners in their true original locations according to the best available evidence, and the subdivision of sections 11 and 13.

Measured distances and directions have been adjusted by Cadastral Measurement Management for Windows (WinCMM), computer software that incorporates a least squares adjustment routine. The adjusted bearings and distances are reported to the nearest second and 0.01 foot.

Except as shown hereon, the lottings and areas are as shown on the plat approved May 6, 1901.

The survey was executed by A. Bert Skeesick, Cadastral Surveyor, beginning May 31, 2001, and completed June 12, 2002, pursuant to Special Instructions dated August 16, 2001, under Group Number 1979, Oregon.

Timber in this area consists of cedar, madrone, fir, maple, chinquapin, and oak.

The tie to the geodetic control station is reported as mean bearing and sea level distance.

LEGEND

- ◇ Original corner previously remonumented
- ◆ Original corner remonumented this survey
- □ Corner previously established or reestablished
- ■ Corner previously established or reestablished; remonumented this survey
- ● Corner established or reestablished this survey

UNITED STATES DEPARTMENT OF THE INTERIOR
BUREAU OF LAND MANAGEMENT

Portland, Oregon June 24, 2004

This plat is strictly conformable to the approved field notes, and the survey, having been correctly executed in accordance with the requirements of law and the regulations of this Bureau, is hereby accepted.

For the Director

Mary J. M. Hatch

Chief Cadastral Surveyor of Oregon