TOWNSHIPS 25 & 26 SOUTH, RANGE 2 WEST, OF THE WILLAMETTE MERIDIAN, OREGON

DEPENDENT RESURVEY

FILED
Date: 2/24/2022 By: JC
This survey consists of:
Map: T25-2 2021-1; T26-2 2021-1
Line VOL. 59
Notes: PGS 23908-23926

DOUGLAS COUNTY SURVEYOR

OFFICIALLY FILED: 6/21/2021

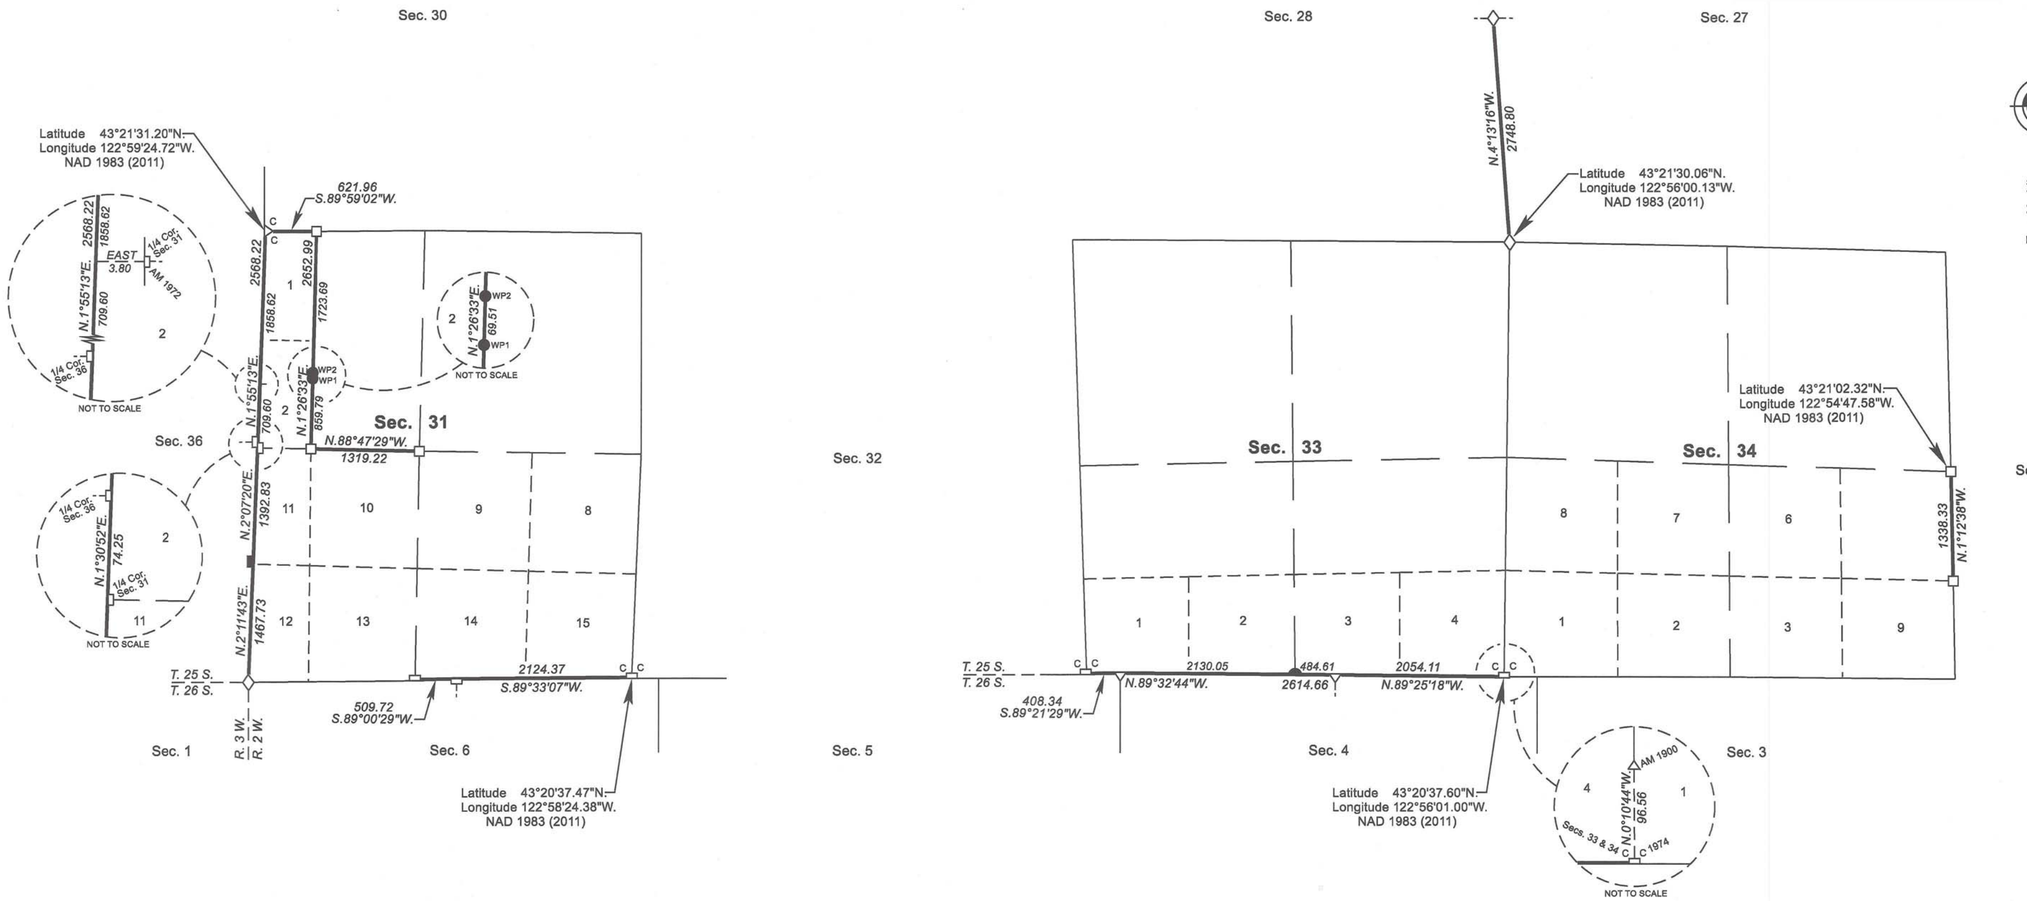

A history of surveys, corner descriptions, and other relevant information are contained in the field notes.

This plat represents the dependent resurvey of a portion of the north boundary, Township 26 South, Range 2 West, and portions of the west boundary, subdivisional lines, and subdivision of section lines of section 31, designed to restore the corners in their true original locations according to the best available evidence, Township 25 South, Range 2 West, Willamette Meridian, Oregon.

Official areas based on the measurements of this survey have been returned for federal interest land where indicated. Aliquot part legal subdivisions retain their aliquot characteristics and refer to precisely the same land as that which was previously identified by its original survey or description. Except as indicated hereon, the lottings and areas are as shown on the plats approved May 6, 1901, and March 7, 1977.

Survey executed by Jeffrey O. Covington, Cadastral Surveyor, beginning May 10, 2018, and completed July 30, 2020, pursuant to special instructions approved May 4, 2018, for Group No. 2919, Oregon.

LEGAL SUBDIVISION	OFFICIAL ACRES
SECTION 31	
LOT 1	19.06
LOT 2	19.40
TOTAL AREA FEDERAL INTEREST LAND RESURVEYED	38.46

1300 650 0 1300 2600 3900 5200
Scale in Feet

LEGEND

- ◇ Original corner previously remonumented
- □ Corner previously established or reestablished
- ■ Corner previously established or reestablished; remonumented this survey
- ● Corner established or reestablished this survey

UNITED STATES DEPARTMENT OF THE INTERIOR
BUREAU OF LAND MANAGEMENT

Portland, Oregon

This plat is strictly conformable to the approved field notes, and the survey, having been correctly executed in accordance with the requirements of law and the regulations of this Bureau, is hereby accepted.

For the Director
Mary J. M. Hartel
Chief Cadastral Surveyor of Oregon

March 24, 2021
Date

JJ