2178

Township No. 25 South Range No. 5 East of the Willamette Meridian Oregon

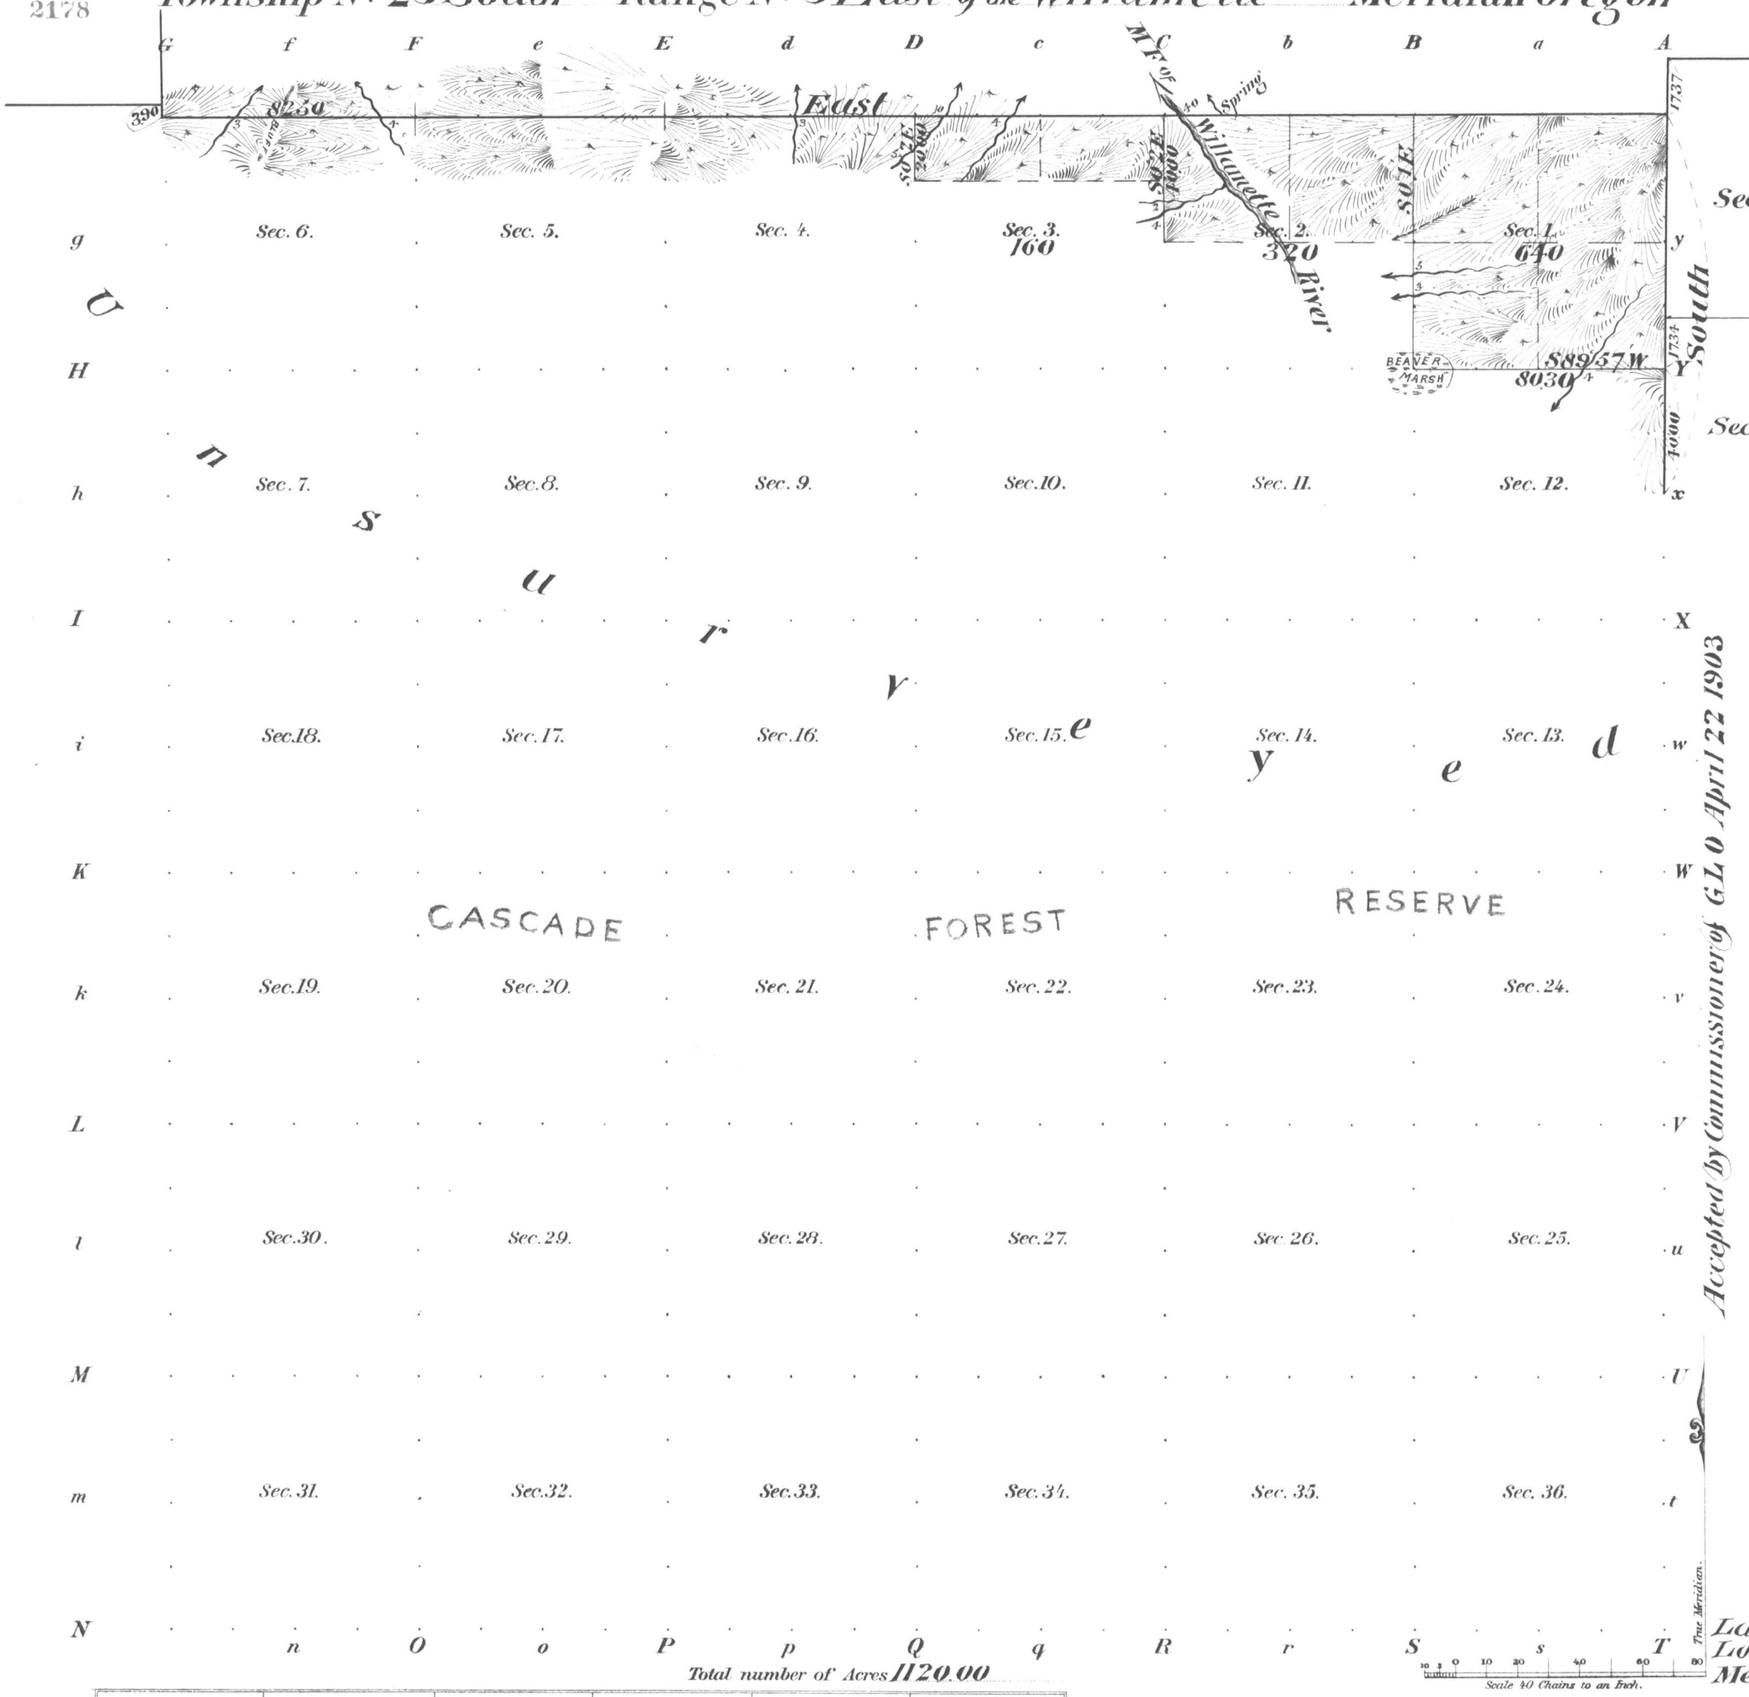

Total number of Acres 1120.00

Surveys Designated	By Whom Surveyed	Date of Contract	Amount of Surveys M. Ch.s Lk.s	When Surveyed	No. of Contract
Township lines N and part of E Bdy Subdivisions	Perkins Mensch AND Keating	July 25 1902			751
	" " "	" " "	2 60 30	Sept. 16 1902	"

Latitude 43° 25' N.
Longitude 122° 8' W
Mean Mag Dec. 19° 30' E

At cor to Secs. 1, 2, 35 and 36 on N Bdy of T.

The above Map of Township No. 25 South, of Range No. 5 East of the Willamette Meridian, Oregon, is strictly conformable to the field notes of the survey thereof on file in this Office, which have been examined and approved.

Surveyor General's Office,
Portland Oregon Mar 4 1903

Henry Mickelsen
Sur. Gen. for Oregon

Accepted by Commissioner of G.L.O. April 22 1903

Meanders of

Posts	Courses	Ch.s Lk.s	Posts	Courses	Ch.s Lk.s	Posts	Courses	Ch.s Lk.s

Deposited by Oregon and California Land Co.

For Field Work	$ 70.50	
" Office Work	20.00	
" Field Examination	15.00	105.50
Cost of Field Work		
" " Office	20.00	
" " Field Examination	15.00	
Amount Refunded		

THE NEBBLE PETERS CO. LITHO. WASHINGTON, D.C.