831

"Supplemental Plat of W½ Sec. 6."

Township No. 25 South Range No. 6 West of the Willamette Meridian Oregon.

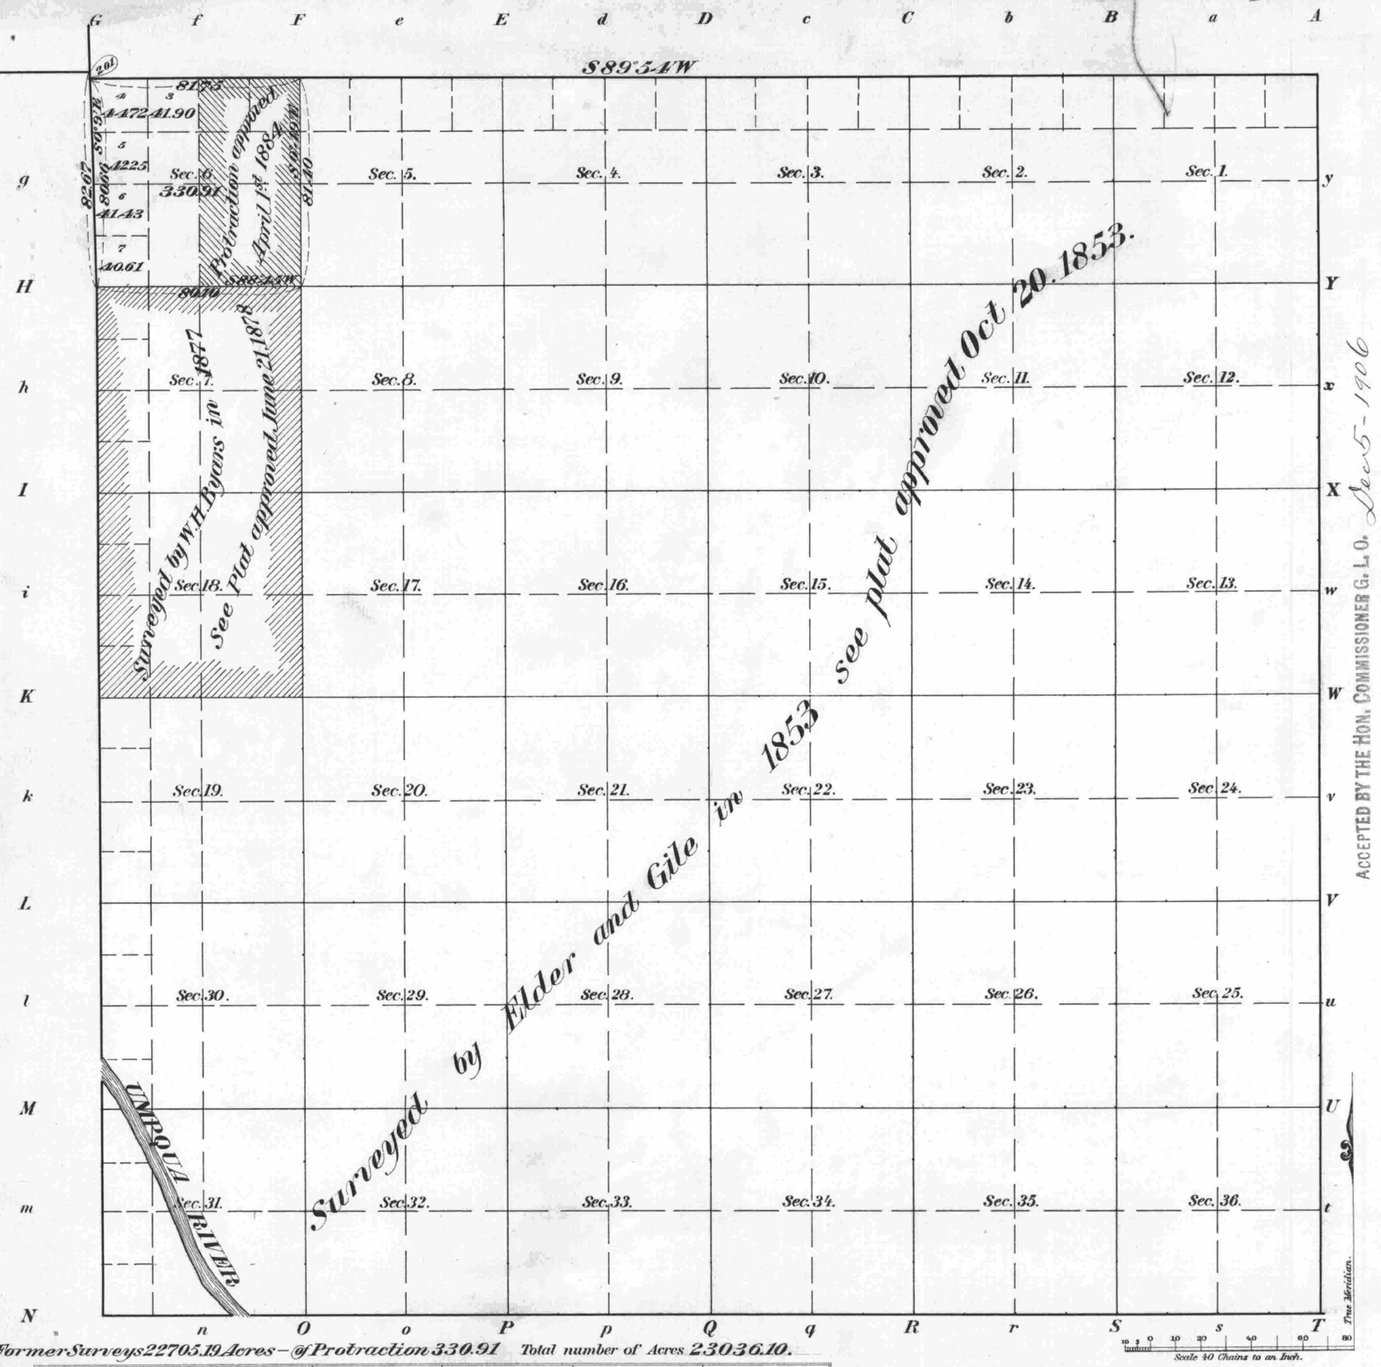

ACCEPTED BY THE HON. COMMISSIONER G. L. O. Dec. 5 - 1906

Meanders of								
Posts	Courses	Ch.s Lk.s	Posts	Courses	Ch.s Lk.s	Posts	Courses	Ch.s Lk.s

Area of Former Surveys 22705.19 Acres – of Protraction 330.91 Total number of Acres 23036.10.

Surveys Designated	By Whom Surveyed	Date of Contract	Amount of Surveys M. Ch.s Lk.s	When Surveyed
Township lines				
Subdivisions				

The above supplemental plat of the protraction of the West half of Sec. 6, Township No. 25 South, Range No. 6 West of the Willamette Meridian Oregon, made by order of Hon Commissioner's Letter E, dated Feb. 8. 1905. is strictly conformable to the field notes of the survey thereof on file in this office, which have been examined and approved.

Surveyor General's Office
Portland, Oregon Feb. 17th 1905

Geo. W. Dale
Sur. Gen'l for Oregon.

S.C.

The above Map of Township No. ..... of Range No. ..... Meridian, ... is strictly conformable to the field notes of the survey thereof on file in this Office, which have been examined and approved.

Surveyor General's Office, ...

Sur. Gen'l

THE NORRIS PETERS CO. LITHO. WASHINGTON, D. C.