Township No. 25 South Range No. 7 West of the Willamette Meridian Oregon

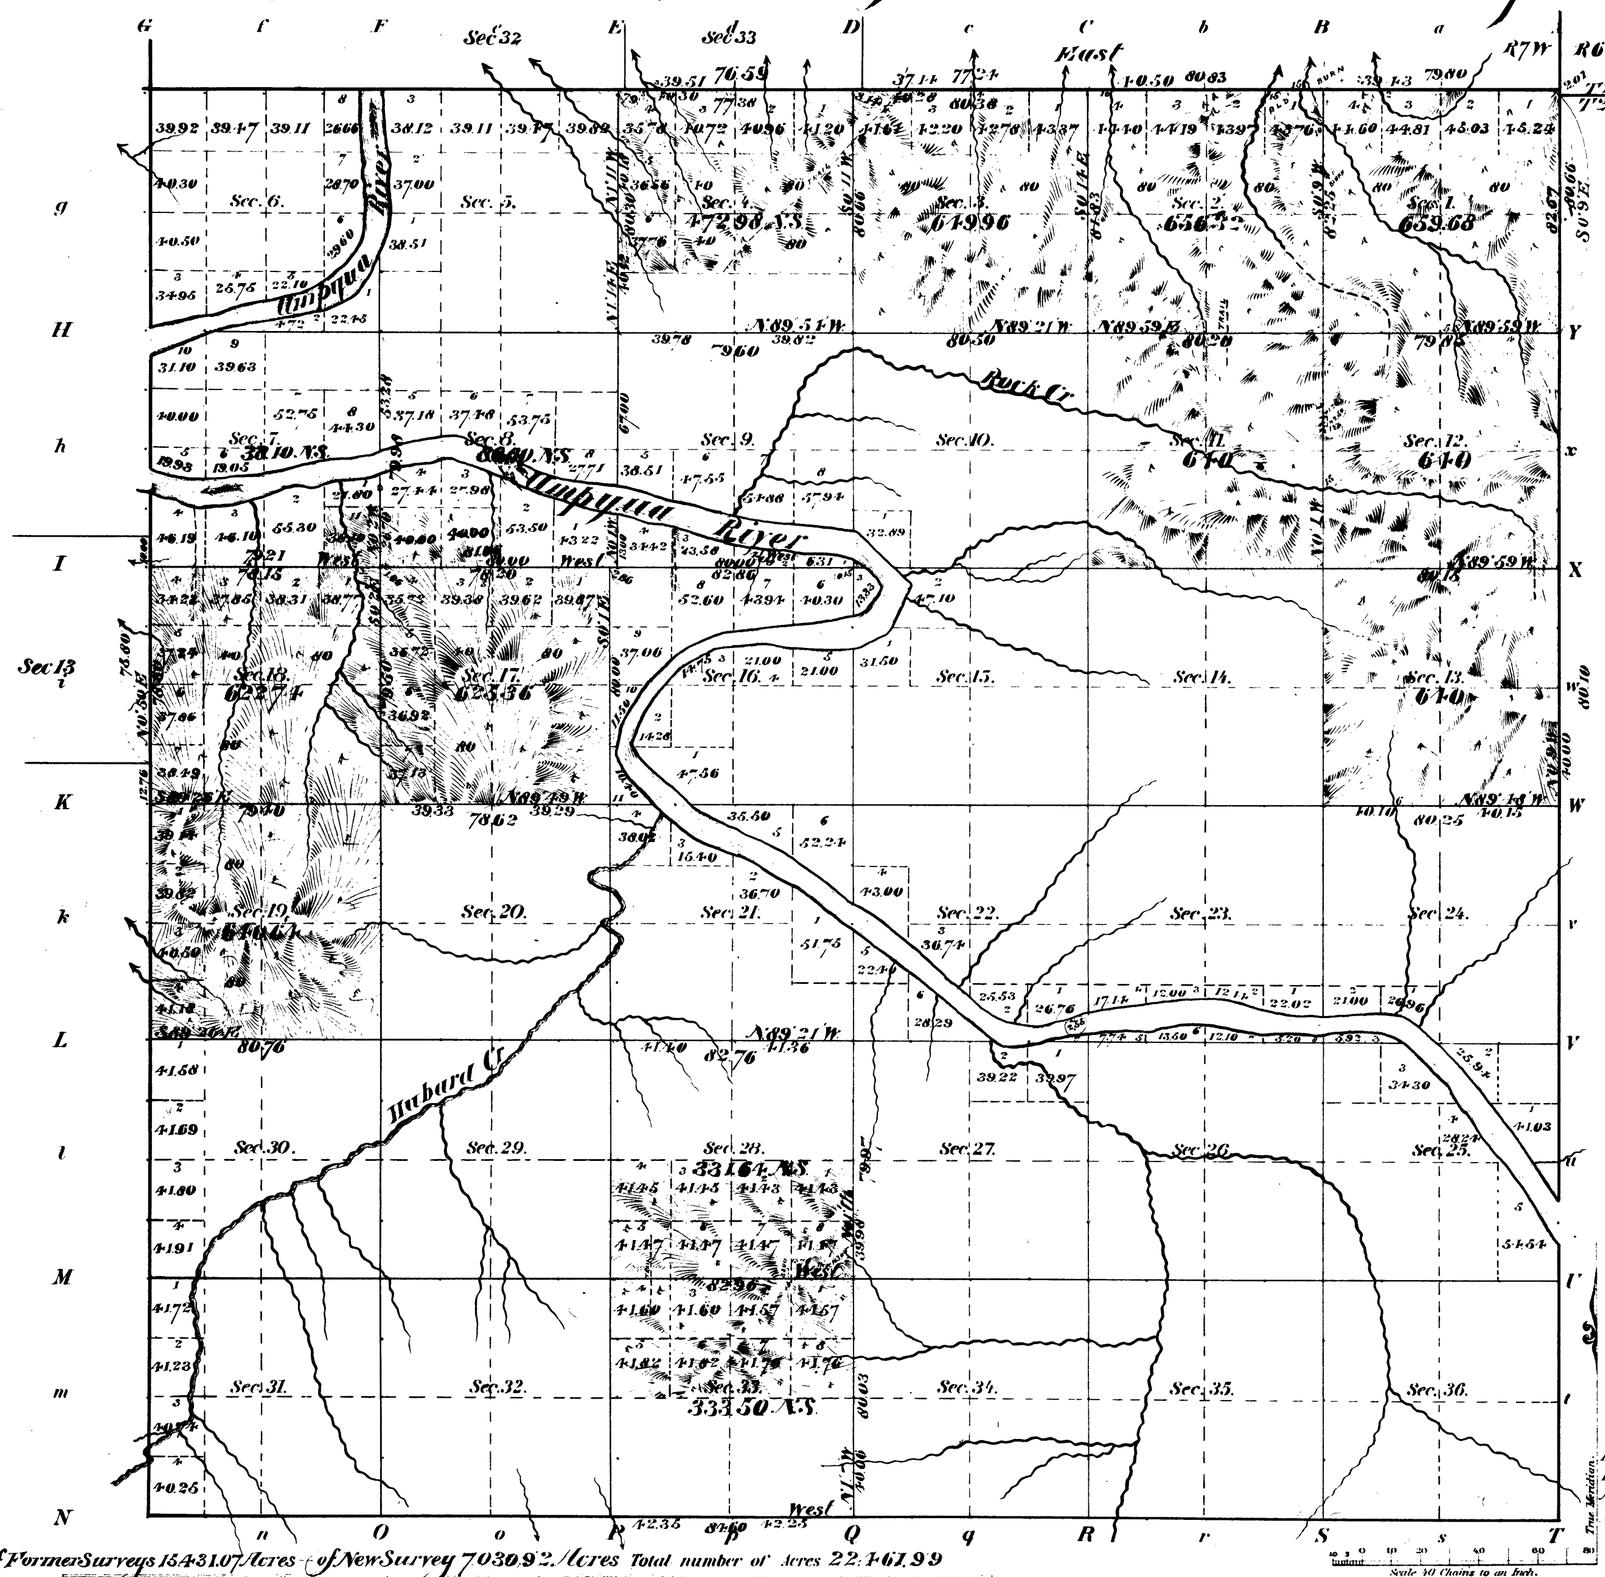

Latitude 43° 22' N
Longitude 123° 27' W
Mean mag. dec.t 20° E.
} Near N.E. Cor. of Sec. 36

CORRECTED BY THE HON. COMMISSIONER G. L. O. December 7. 1898

Area of Former Surveys 15431.07 Acres of New Survey 7030.92 Acres Total number of Acres 22461.99

Surveys Designated	By Whom Surveyed	Date of Contract	Amount of Surveys M.	Ch.s	Lk.s	When Surveyed	No. of Contract
Township lines	William P. Heyton	May 21 1896					656
E. Bd. of Sec. 1							
Subdivisions	" " "	" " "	14	45	71	Oct. 27 Nov. 10 1896	"
Connections	" " "	" " "		26	68		"
Sum. B.ds of T.s 6 and 7	Dennis Hathorn	March 22 1856				1856	63
Bds. of Sec.s 24 25 & 30							
N. B.ds of Sec.s 5 & 6 W. B.ds of Sec.s 6, 7							
W. Bds. of Sec.s 30 & 31	William H. Byers	June 8 1857				1857	73
" " 18 and 19	A. Reed & C. F. Cook	March 11 1874				1874	202
East B.ds of Sec.s 12 & 13	Wm. H. Byers	May 26 1881				1881	392
		August 22 1877				1877	272

The above Map of Township No. 25 South of Range No. 7 West of the Willamette Meridian Oregon is strictly conformable to the field notes of the survey thereof on file in this Office, which have been examined and approved.

Surveyor General's Office.
Portland Oregon Nov. 20. 1897

Robert A. Habershaw
Sur. Gen.l for Oregon

THE NORRIS PETERS CO. LITHO. WASHINGTON, D.C.