TOWNSHIP 25 SOUTH, RANGE 7 WEST, OF THE WILLAMETTE MERIDIAN, OREGON.

DEPENDENT RESURVEY

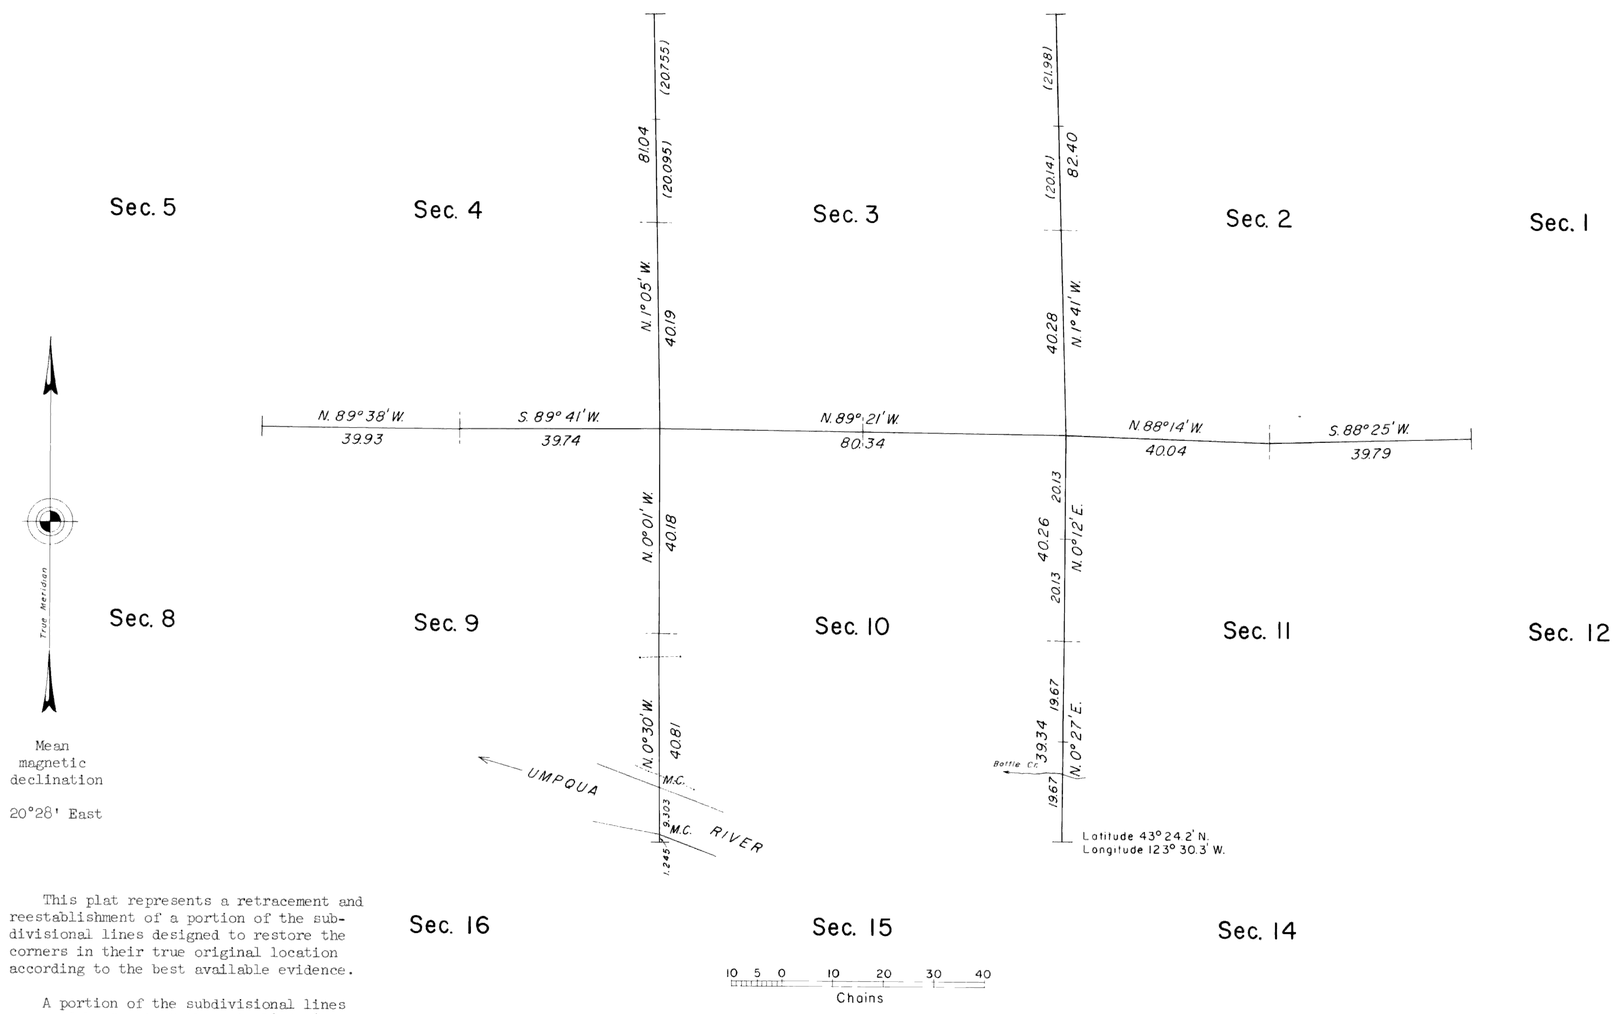

Mean magnetic declination

20°28' East

This plat represents a retracement and reestablishment of a portion of the subdivisional lines designed to restore the corners in their true original location according to the best available evidence.

A portion of the subdivisional lines surveyed by Dennis Hathorn in 1857-58.

A portion of the north boundary surveyed by Williams R. Whipple in 1893.

A portion of the north boundary retraced and a portion of the subdivisional lines surveyed by William P. Heydon in 1896.

Dependent resurvey of a portion of the subdivisional lines of T. 25 S., R. 7 W., Willamette Meridian, Oregon, executed by Irving Zirpel, Jr., September 15 to October 6, 1958, under Special Instructions dated August 8, 1958, which provided for the surveys included under Group 411, Oregon.

UNITED STATES DEPARTMENT OF THE INTERIOR
BUREAU OF LAND MANAGEMENT
Washington, D.C. December 21, 1959

This plat is strictly conformable to the approved field notes, and the survey, having been correctly executed in accordance with the requirements of law and the regulations of this Bureau, is hereby accepted.

For the Director

Donald R. Clement

Cadastral Engineering Staff Officer