ORIGINAL

TOWNSHIP 25 SOUTH, RANGE 7 WEST, OF THE WILLAMETTE MERIDIAN, OREGON.

DEPENDENT RESURVEY

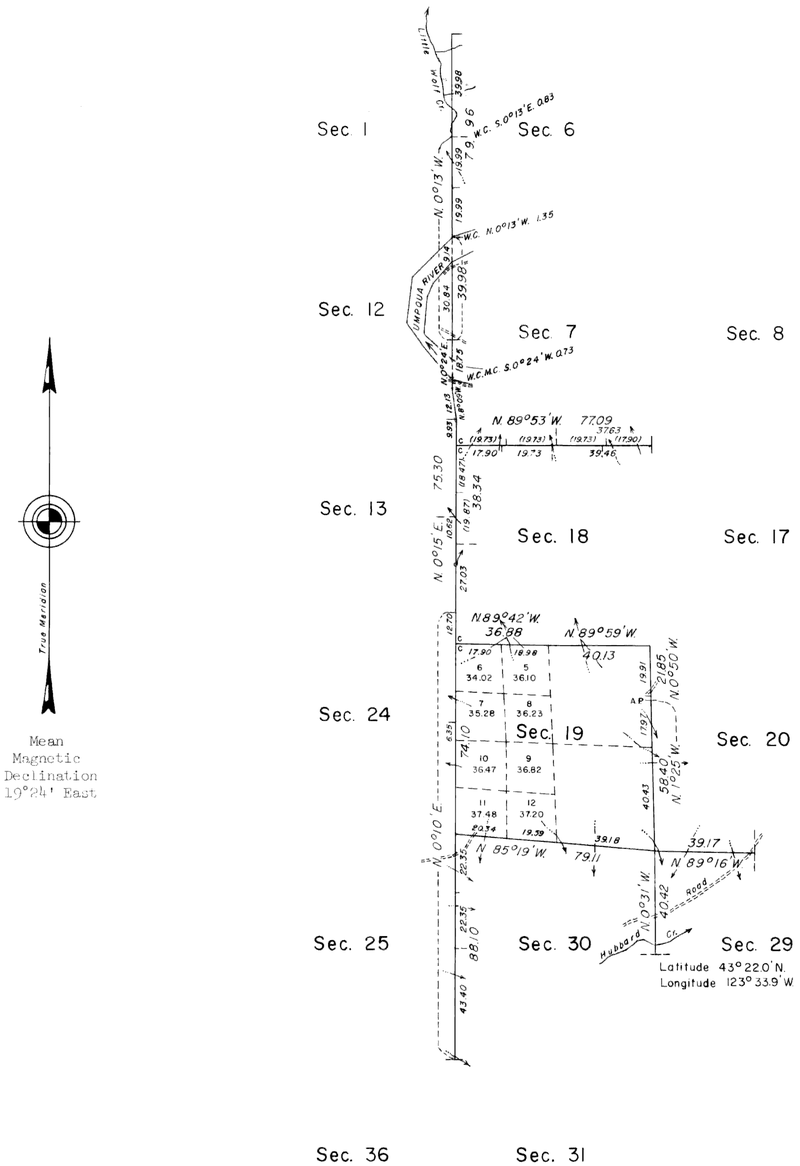

This plat represents a retracement and reestablishment of a portion of the west boundary and a portion of the subdivisional lines, designed to restore the corners in their true original locations according to the best available evidence; and, excepting as new or modified vacant subdivisions are shown hereon, the lottings and areas are as shown on the plat approved November 20, 1897.

Portions of the west boundary and subdivisional lines were surveyed by Dennis Hathorn in 1857-58, and by William H. Byars in 1874. In 1881, Addison R. and Samuel C. Flint surveyed, retraced, and resurveyed portions of the west boundary. William P. Heydon retraced portions of the west boundary and subdivisional lines and completed the survey of the township in 1896.

Survey executed by John M. Jelley and Donald R. Beck, August 20 to October 15, 1964, under Special Instructions dated August 13, 1964, which provide for the surveys included under Group No. 563, Oregon.

UNITED STATES DEPARTMENT OF THE INTERIOR
BUREAU OF LAND MANAGEMENT
Washington, D. C. April 28, 1966

This plat is strictly conformable to the approved field notes, and the survey, having been correctly executed in accordance with the requirements of law and the regulations of this Bureau, is hereby accepted.

For the Director

E. E. Lemington

Chief, Division of Engineering

Timber in this area consists of fir, hemlock, cedar, white fir, madrone, alder, dogwood, yew, maple, and myrtle.

Area resurveyed: 609.60 Acres

BmK

WMR