ORIGINAL

TOWNSHIP 25 SOUTH, RANGE 7 WEST, OF THE WILLAMETTE MERIDIAN, OREGON.

DEPENDENT RESURVEY

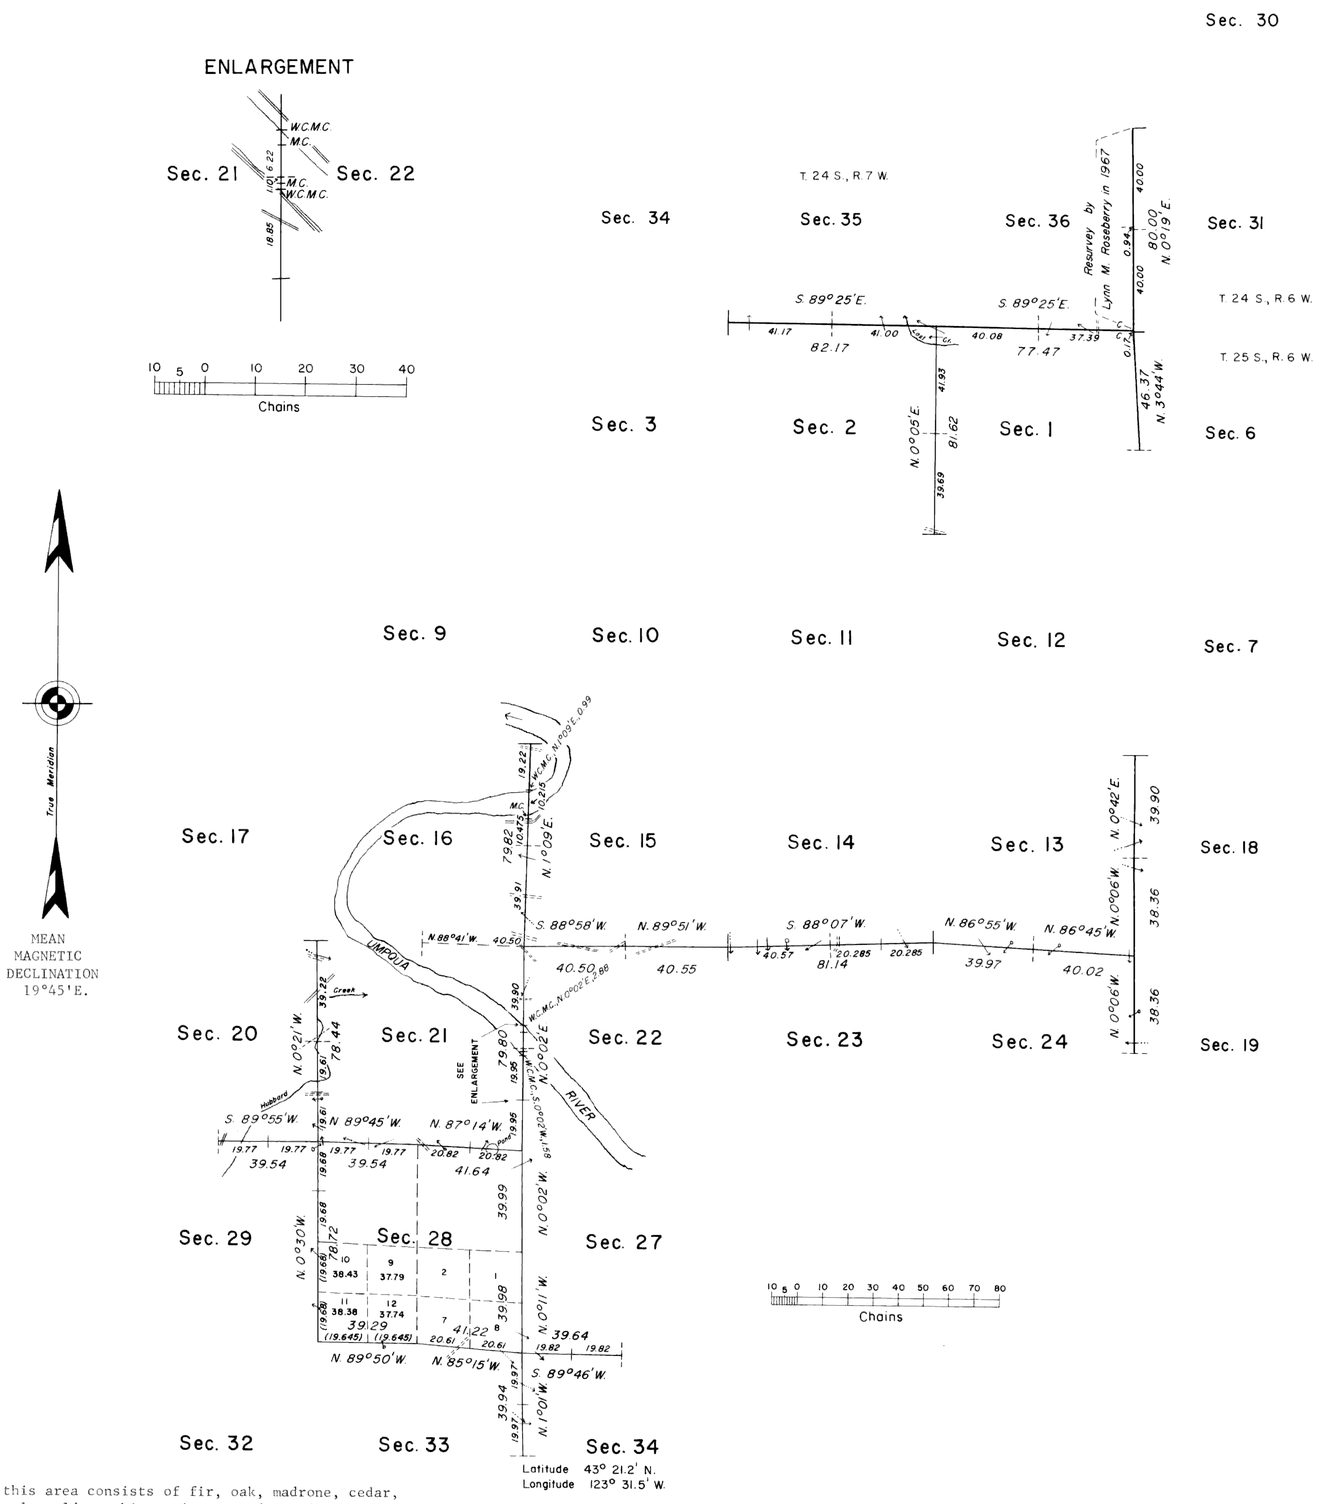

Timber in this area consists of fir, oak, madrone, cedar, hemlock, maple, alder, chinquapin, yew, dogwood, and ash.

JK

This plat represents a retracement and reestablishment of a portion of the east and north boundaries and subdivisional lines of T. 25 S., R. 7 W., Willamette Meridian, Oregon designed to restore the corners in their true original location according to the best available evidence.

Excepting as new or modified vacant subdivisions are shown hereon, the lottings and areas are as shown on the plat approved November 20, 1897.

Robert Elder and Henry Gile surveyed the south three miles of the east boundary. In this same year they established the corner of Townships 24 and 25 South, Range 6 West.

Dennis Hathorn surveyed a portion of the subdivisional lines, in 1856 and 1858.

William H. Byars surveyed a portion of the east boundary and subdivisional lines in 1874 and 1877.

Williams R. Whipple surveyed the east four miles of the north boundary, in 1893.

William P. Heydon retraced portions of the east boundary, north boundary, and subdivisional lines and completed the survey of the east boundary and subdivisional lines, in 1896.

Irving Zirpel, Jr., dependently resurveyed a portion of the subdivisional lines, in 1958.

John M. Jelley and Donald R. Beck, dependently resurveyed a portion of the subdivisional lines, in 1964.

The resurvey was executed by Lynn M. Roseberry, Cadastral Surveyor, from July 20, 1967 to September 25, 1968 under Special Instructions dated July 13, 1967 and Supplemental Special Instructions dated May 24, 1968 for Group No. 645, Oregon.

UNITED STATES DEPARTMENT OF THE INTERIOR
BUREAU OF LAND MANAGEMENT
Washington, D.C. December 5, 1975

This plat is strictly conformable to the approved field notes, and the survey, having been correctly executed in accordance with the requirements of law and the regulations of this Bureau, is hereby accepted.

For the Director

Roger T. Barron

Acting Chief, Division of Cadastral Survey