ORIGINAL

TOWNSHIP 25 SOUTH, RANGE 7 WEST, OF THE WILLAMETTE MERIDIAN, OREGON.

DEPENDENT RESURVEY

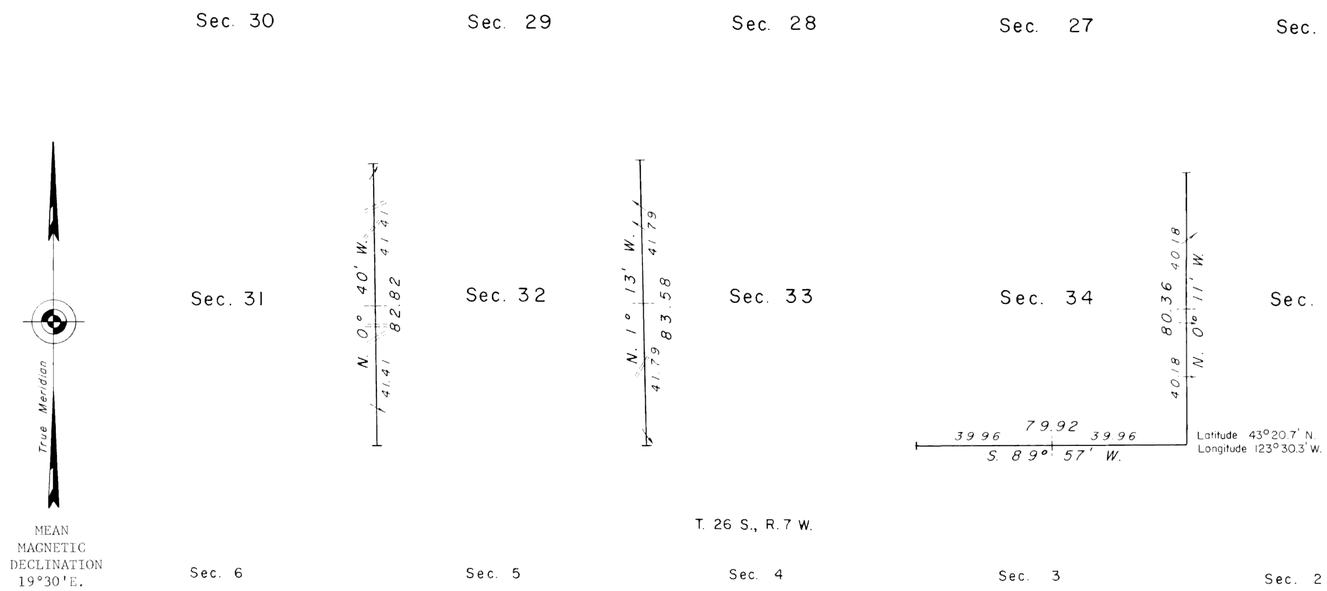

A history of surveys is contained in the field notes.

This plat represents a dependent resurvey of a portion of the south boundary, and a portion of the subdivisional lines, T. 25 S., R. 7 W., Willamette Meridian, Oregon, designed to restore the corners in their ture original locations according to the best available evidence.

Survey executed by G. Steven Popken, Cadastral Surveyor, from May 16, 1975, to July 8, 1975, under Special Instructions dated May 6, 1975, which provided for the surveys included under Group No. 869, Oregon.

UNITED STATES DEPARTMENT OF THE INTERIOR
BUREAU OF LAND MANAGEMENT
Washington, D.C. November 14, 1977

This plat is strictly conformable to the approved field notes, and the survey, having been correctly executed in accordance with the requirements of law and the regulations of this Bureau, is hereby accepted.

For the Director

Bernard W. Stalzer

Chief, Division of Cadastral Survey

Timber in this area consists of fir, cedar, hemlock, maple, madrone, alder, and chinquapin.

TEB