TOWNSHIP 25 SOUTH, RANGE 7 WEST, OF THE WILLAMETTE MERIDIAN, OREGON.

DEPENDENT RESURVEY AND SUBDIVISION OF SECTION 9

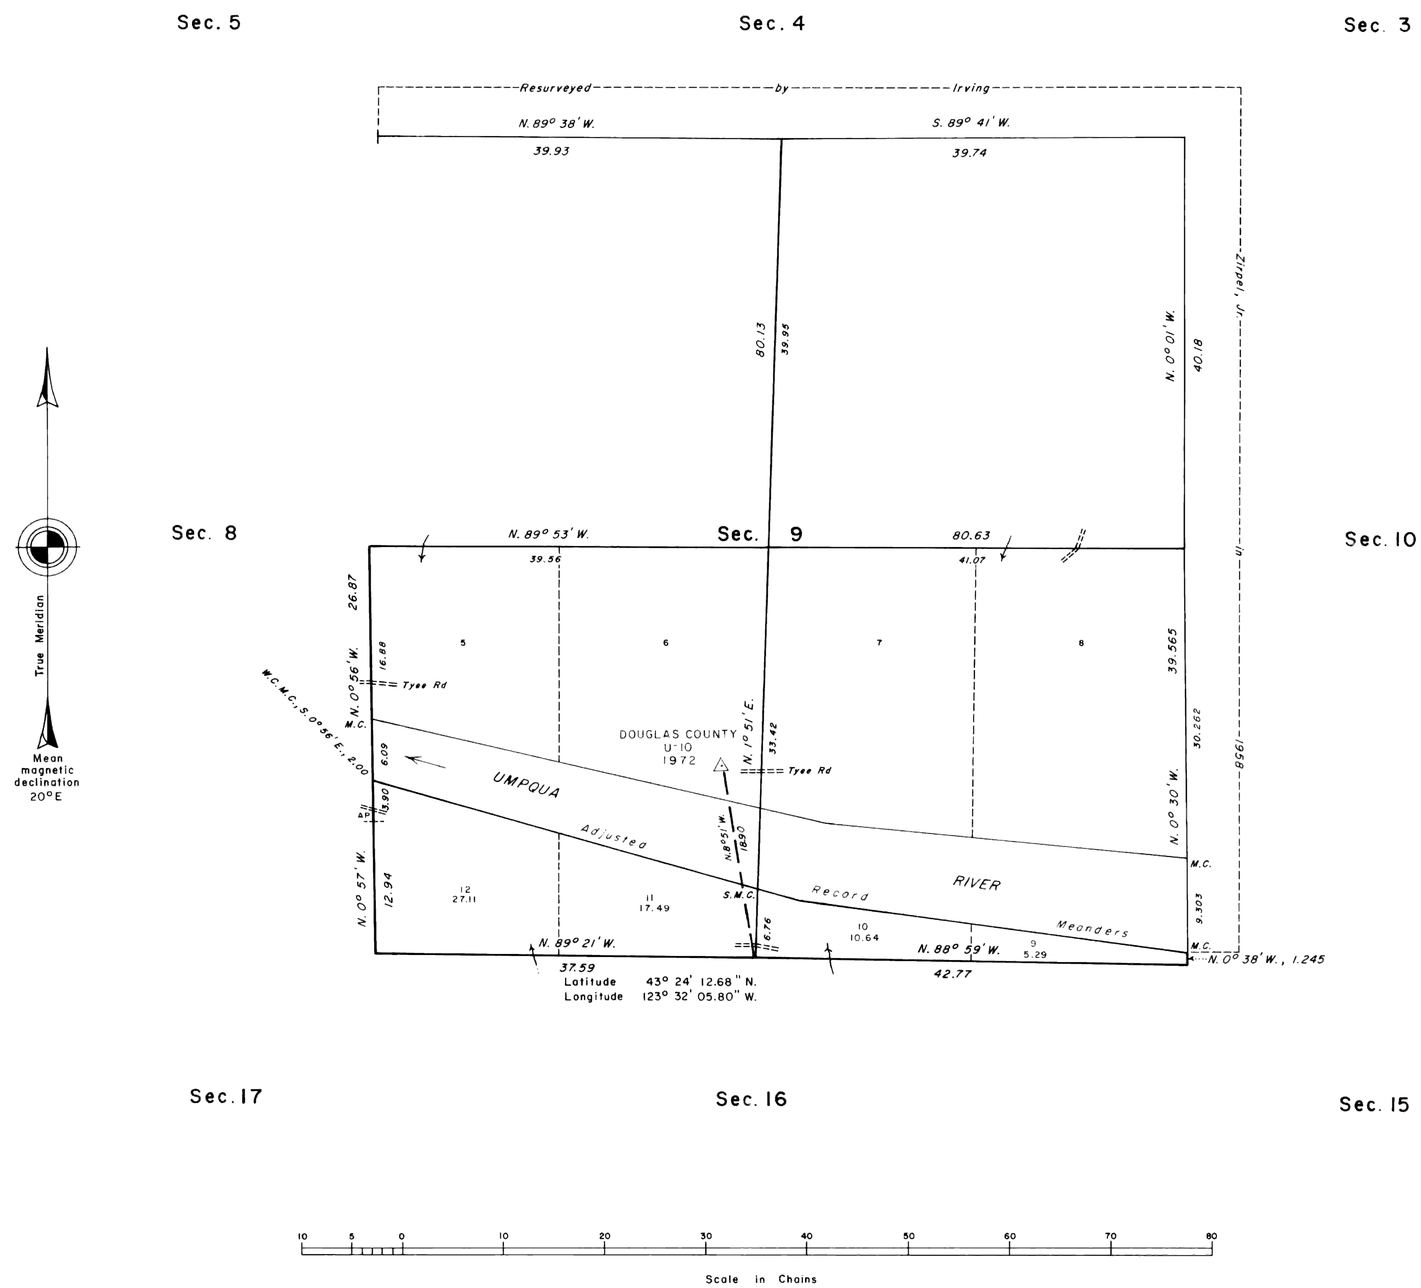

The history of surveys is contained in the field notes.

This plat represents a dependent resurvey of a portion of the subdivisional lines, the retracement of the meanders of the left bank of the Umpqua River, in section 9, T. 25 S., R. 7 W., Willamette Meridian, Oregon, designed to restore the corners in their true original locations according to the best available evidence, and the subdivision of section 9.

Except as shown hereon, the lottings and areas are as shown on the plat approved April 24, 1858.

The survey was executed by Rick A. McMullen, Cadastral Surveyor, beginning August 19, 1985, and completed September 25, 1985, pursuant to Special Instructions dated January 14, 1985, under Group Number 1246, Oregon.

Timber in this area consists of fir, cedar, hemlock, madrone, and oak.

UNITED STATES DEPARTMENT OF THE INTERIOR
BUREAU OF LAND MANAGEMENT
Portland, Oregon November 25, 1987

This plat is strictly conformable to the approved field notes, and the survey, having been correctly executed in accordance with the requirements of law and the regulations of this Bureau, is hereby accepted.

For the Director

William W. Glenn

Chief Cadastral Surveyor of Oregon

HDL