TOWNSHIP 25 SOUTH, RANGE 7 WEST, OF THE WILLAMETTE MERIDIAN, OREGON

DEPENDENT RESURVEY AND SUBDIVISION OF SECTIONS 13 AND 14

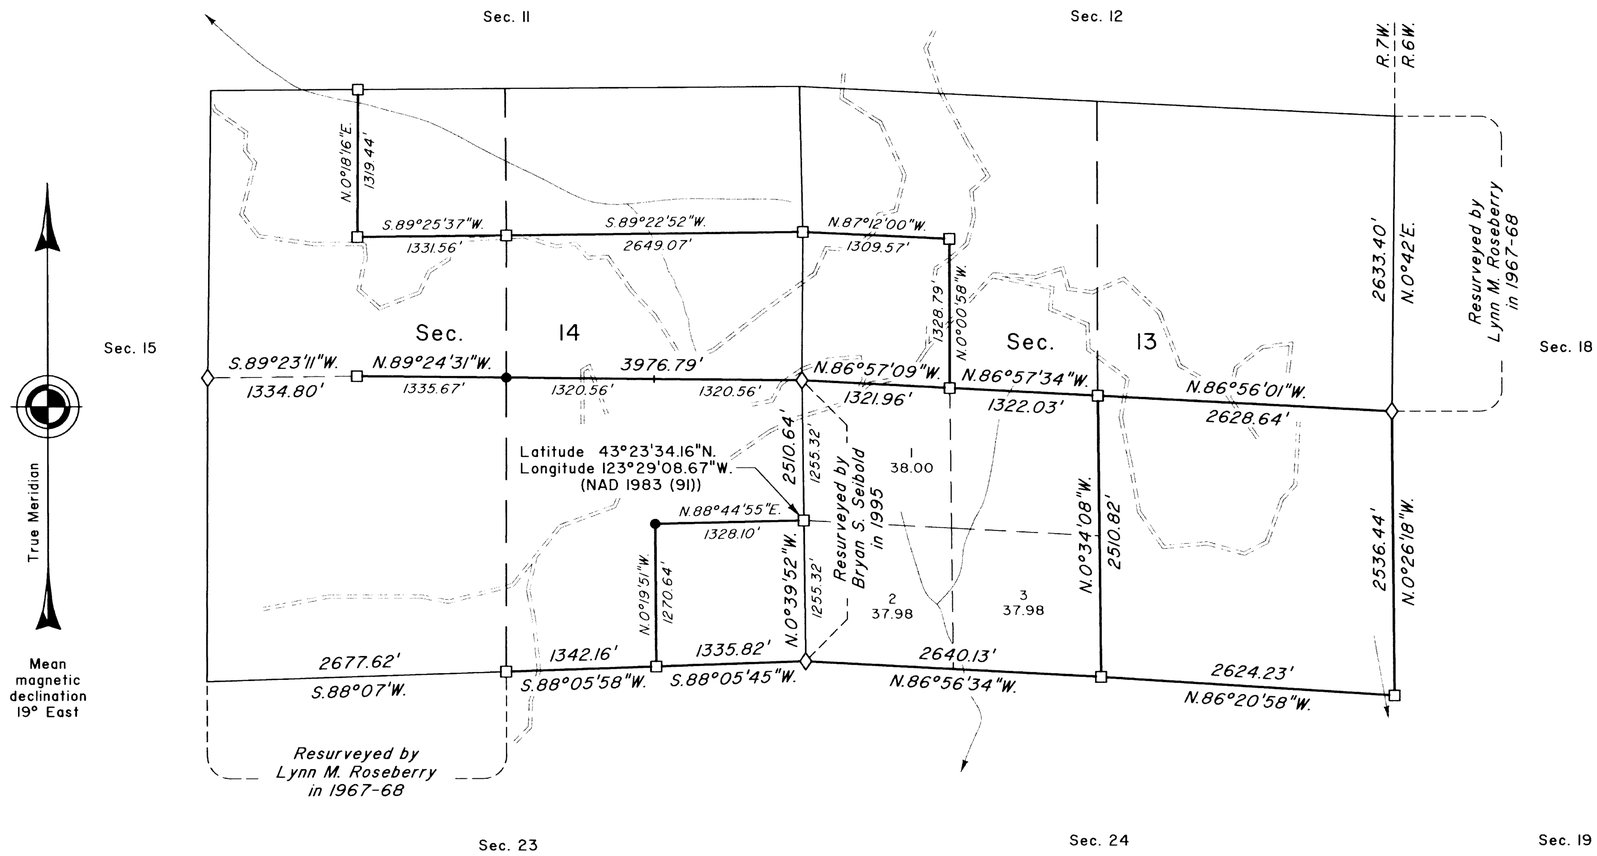

A history of surveys is contained in the field notes.

This plat represents a dependent resurvey of a portion of the subdivisional lines, T. 25 S., R. 7 W., Willamette Meridian, Oregon, designed to restore the corners in their true original locations according to the best available evidence, and the subdivision of sections 13 and 14.

Measured distances and directions have been adjusted by Cadastral Measurement Management (CMM), computer software that incorporates a least squares adjustment routine. The adjusted bearings and distances are reported to the nearest second and 0.01 foot.

The lottings and areas are as shown on the plats approved April 24, 1858, August 2, 1875 and November 20, 1897.

The survey was executed by Timothy J. Moore, Cadastral Surveyor, and Robert H. Browning, Surveying Technician, beginning April 6, 1999, and completed May 13, 1999, pursuant to Special Instructions dated March 24, 1999, under Group Number 1905, Oregon.

Timber in this area consists of fir, cedar, madrone, maple and oak.

LEGEND

- ◇ Original corner previously remonumented
- □ Corner previously established or reestablished
- ● Corner established or reestablished this survey

UNITED STATES DEPARTMENT OF THE INTERIOR
BUREAU OF LAND MANAGEMENT

Portland, Oregon August 15, 2001

This plat is strictly conformable to the approved field notes, and the survey, having been correctly executed in accordance with the requirements of law and the regulations of this Bureau, is hereby accepted.

For the Director

Acting Chief Cadastral Surveyor of Oregon

"See amended plat of survey accepted Sept. 4, 2009, for the correct bearing of the east and west center line of Section 14. see Memorandum dated July 13, 2009, File 9632 (0R957000)."

1000 500 0 1000 2000 3000 4000 5000 6000

Scale in Feet

R.F.B.

United States Department of the Interior

BUREAU OF LAND MANAGEMENT
Oregon State Office
P.O. Box 2965
Portland, OR 97208

TAKE PRIDE IN AMERICA

In Reply Refer to:
9632 (OR957000)

July 13, 2009

Memorandum

To: Chief, Cadastral Survey Section 1

From: Mary J.M. Hartel
Chief Cadastral Surveyor of Oregon

Subject: Correction to official plat, Group 1905, T. 25 S., R. 7 W., Willamette Meridian, Oregon

Staff working on the Geographic Coordinate Data Base (GCDB) have discovered that a portion of the bearing of the east and west center line of section 14, is erroneously reported on the plat and field notes accepted August 15, 2001. The correct bearing for the plat and field notes of the line from the ¼ section corner of sections 13 and 14, to the center W 1/16 section corner of section 14, is S. 89° 24' 31" W. (not N. 89° 24' 31" W.).

Therefore, you are hereby authorized to prepare amended plat and field notes. The plat will contain a statement explaining the reason for the amendment to the official record.

Upon acceptance of the amended plat, you are to have placed on the plat of survey for Group Number 1905, accepted August 15, 2001, the following:

> "See amended plat of survey accepted (Date), for the correct bearing of the east and west center line of Section 14, see Memorandum dated July 13, 2009, File 9632 (OR957000)."