# TOWNSHIP 25 SOUTH, RANGE 7 WEST, OF THE WILLAMETTE MERIDIAN, OREGON

## DEPENDENT RESURVEY AND SUBDIVISION OF SECTION 2

FILED
Date: 1/12/2009 By: JC
This survey consists of:
~~Map~~: BLM LINE NOTES
~~Narrative~~: VOL. 55
~~Corner Rpt~~: PAGES 21583-94
DOUGLAS COUNTY SURVEYOR

A history of surveys is contained in the field notes.

This plat represents a dependent resurvey of a portion of the north boundary and subdivisional lines, T. 25 S., R. 7 W., Willamette Meridian, Oregon, designed to restore the corners in their true original locations according to the best available evidence, and the subdivision of section 2.

Measured distances and directions have been adjusted by computer software that incorporates a least squares adjustment routine. The adjusted bearings and distances are reported to the nearest second and 0.01 foot.

The lottings and areas are as shown on the plat approved November 20, 1897.

The survey was executed by A. Bert Skeesick, Cadastral Surveyor, beginning July 12, 2004, and completed August 10, 2004, pursuant to Special Instructions dated May 19, 2004, under Group Number 2079, Oregon.

Timber in this area consists of fir, cedar, maple, madrone, and alder.




LEGEND

◇ Original corner previously remonumented

□ Corner previously established or reestablished

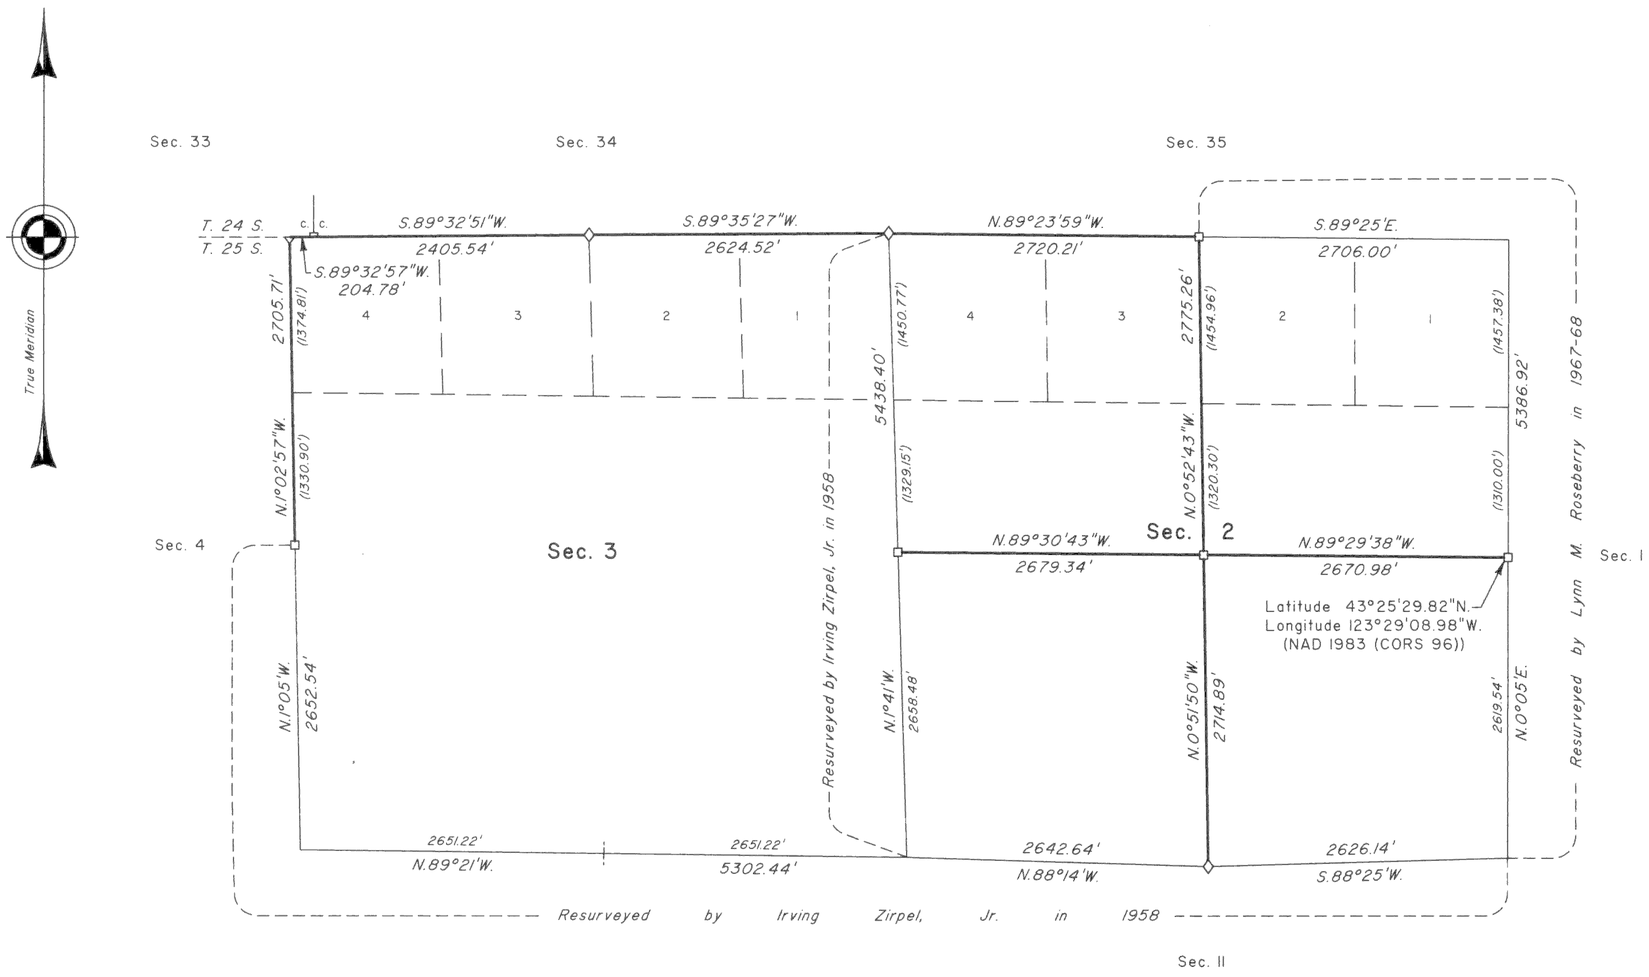


UNITED STATES DEPARTMENT OF THE INTERIOR
BUREAU OF LAND MANAGEMENT

Portland, Oregon

This plat is strictly conformable to the approved field notes, and the survey, having been correctly executed in accordance with the requirements of law and the regulations of this Bureau, is hereby accepted.

For the Director

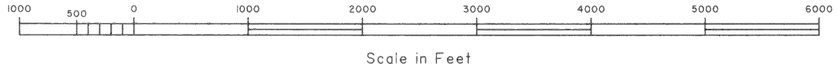John P. Fairsworth, Acting

Chief Cadastral Surveyor of Oregon

November 24, 2008

Date

33