TOWNSHIP 25 SOUTH, RANGE 7 WEST, OF THE WILLAMETTE MERIDIAN, OREGON

AMENDED PLAT

FILED
Date: 11/16/2009 By: JC
This survey consists of:
Map: VOL. 56 PGS 21823-27
~~Narrative:~~
~~Corner Rpt:~~
DOUGLAS COUNTY SURVEYOR

OFFICIALLY FILED:

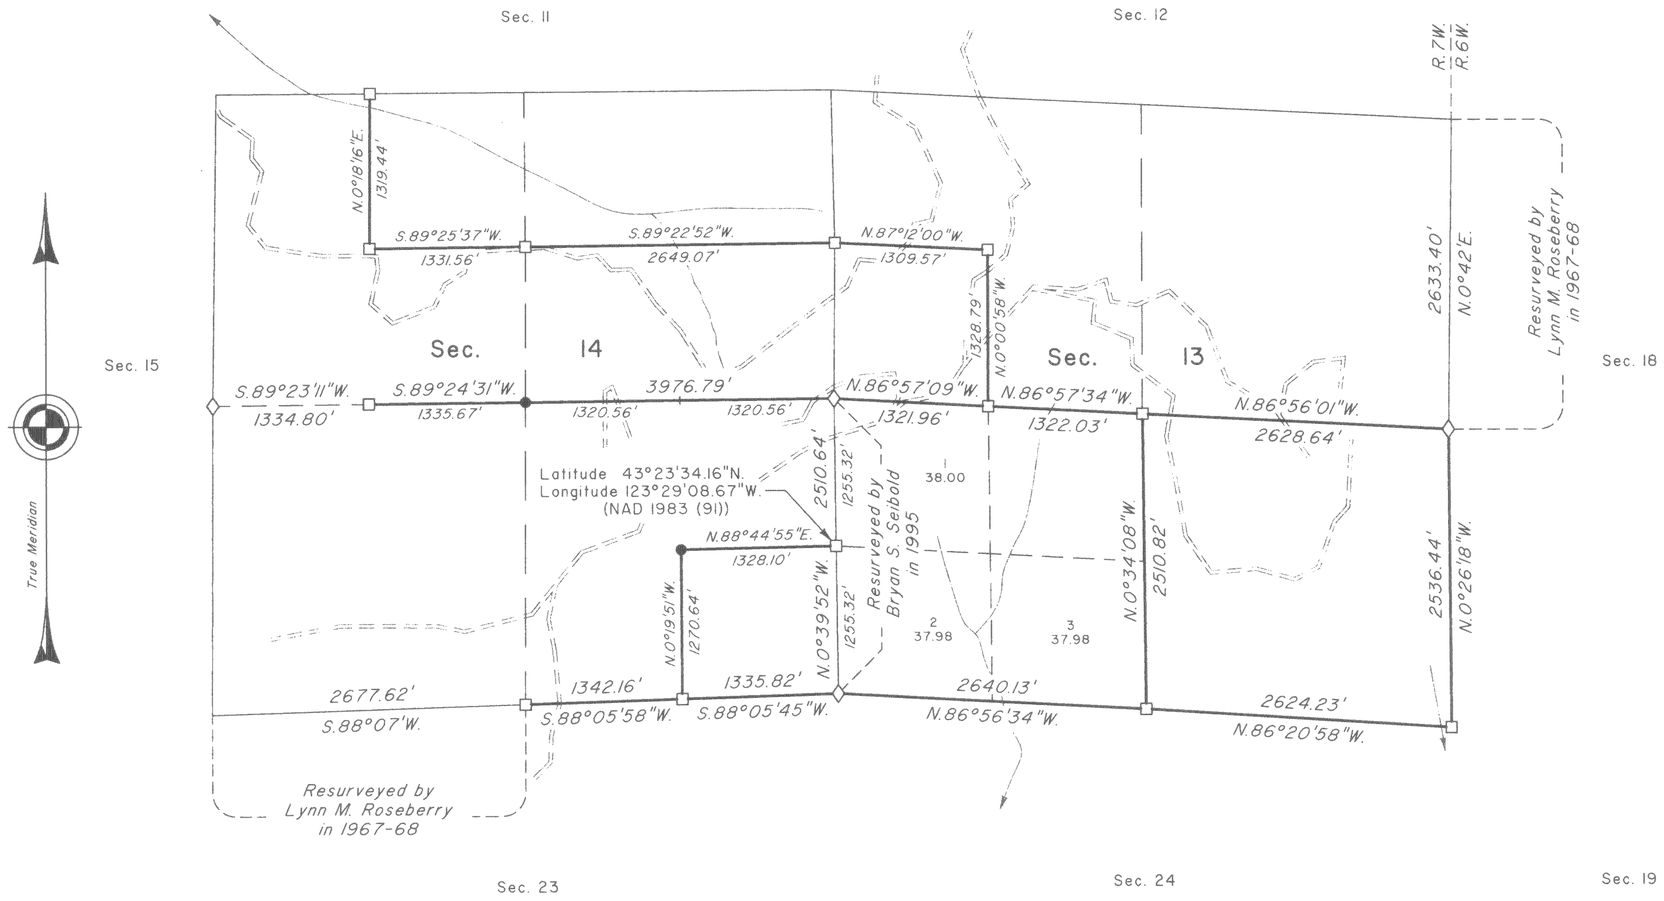

This plat corrects the bearing between the 1/4 section corner of sections 13 and 14 and the center W 1/16 section corner of section 14, T. 25 S., R. 7 W., Willamette Meridian, Oregon as shown on the official plat accepted April 15, 2001. The bearing is based on the amended field notes as authorized by memorandum from Chief Cadastral Surveyor of Oregon, dated July 13, 2009, File 9632 (OR-957000).

LEGEND

- ◇ Original corner previously remonumented
- □ Corner previously established or reestablished
- ● Corner established or reestablished this survey

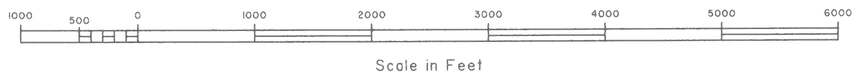

UNITED STATES DEPARTMENT OF THE INTERIOR
BUREAU OF LAND MANAGEMENT

Portland, Oregon

This plat is strictly conformable to the approved field notes, and the survey, having been correctly executed in accordance with the requirements of law and the regulations of this Bureau, is hereby accepted.

For the Director

Mary J. M. Hunt

Chief Cadastral Surveyor of Oregon

September 4, 2009
Date

AMENDS PLAT ACCEPTED
AUG. 15, 2001

United States Department of the Interior

BUREAU OF LAND MANAGEMENT
Oregon State Office
P.O. Box 2965
Portland, OR 97208

TAKE PRIDE IN AMERICA

In Reply Refer to:
9632 (OR957000)

July 13, 2009

Memorandum

To: Chief, Cadastral Survey Section 1

From: Mary J.M. Hartel
Chief Cadastral Surveyor of Oregon

Subject: Correction to official plat, Group 1905, T. 25 S., R. 7 W., Willamette Meridian, Oregon

Staff working on the Geographic Coordinate Data Base (GCDB) have discovered that a portion of the bearing of the east and west center line of section 14, is erroneously reported on the plat and field notes accepted August 15, 2001. The correct bearing for the plat and field notes of the line from the ¼ section corner of sections 13 and 14, to the center W 1/16 section corner of section 14, is S. 89° 24' 31" W. (not N. 89° 24' 31" W.).

Therefore, you are hereby authorized to prepare amended plat and field notes. The plat will contain a statement explaining the reason for the amendment to the official record.

Upon acceptance of the amended plat, you are to have placed on the plat of survey for Group Number 1905, accepted August 15, 2001, the following:

> "See amended plat of survey accepted (Date), for the correct bearing of the east and west center line of Section 14, see Memorandum dated July 13, 2009, File 9632 (OR957000)."