(4-675 a)

Township No. 25 South Range No. 8 West, Willamette Meridian,

G f F e E d D c C b B a A

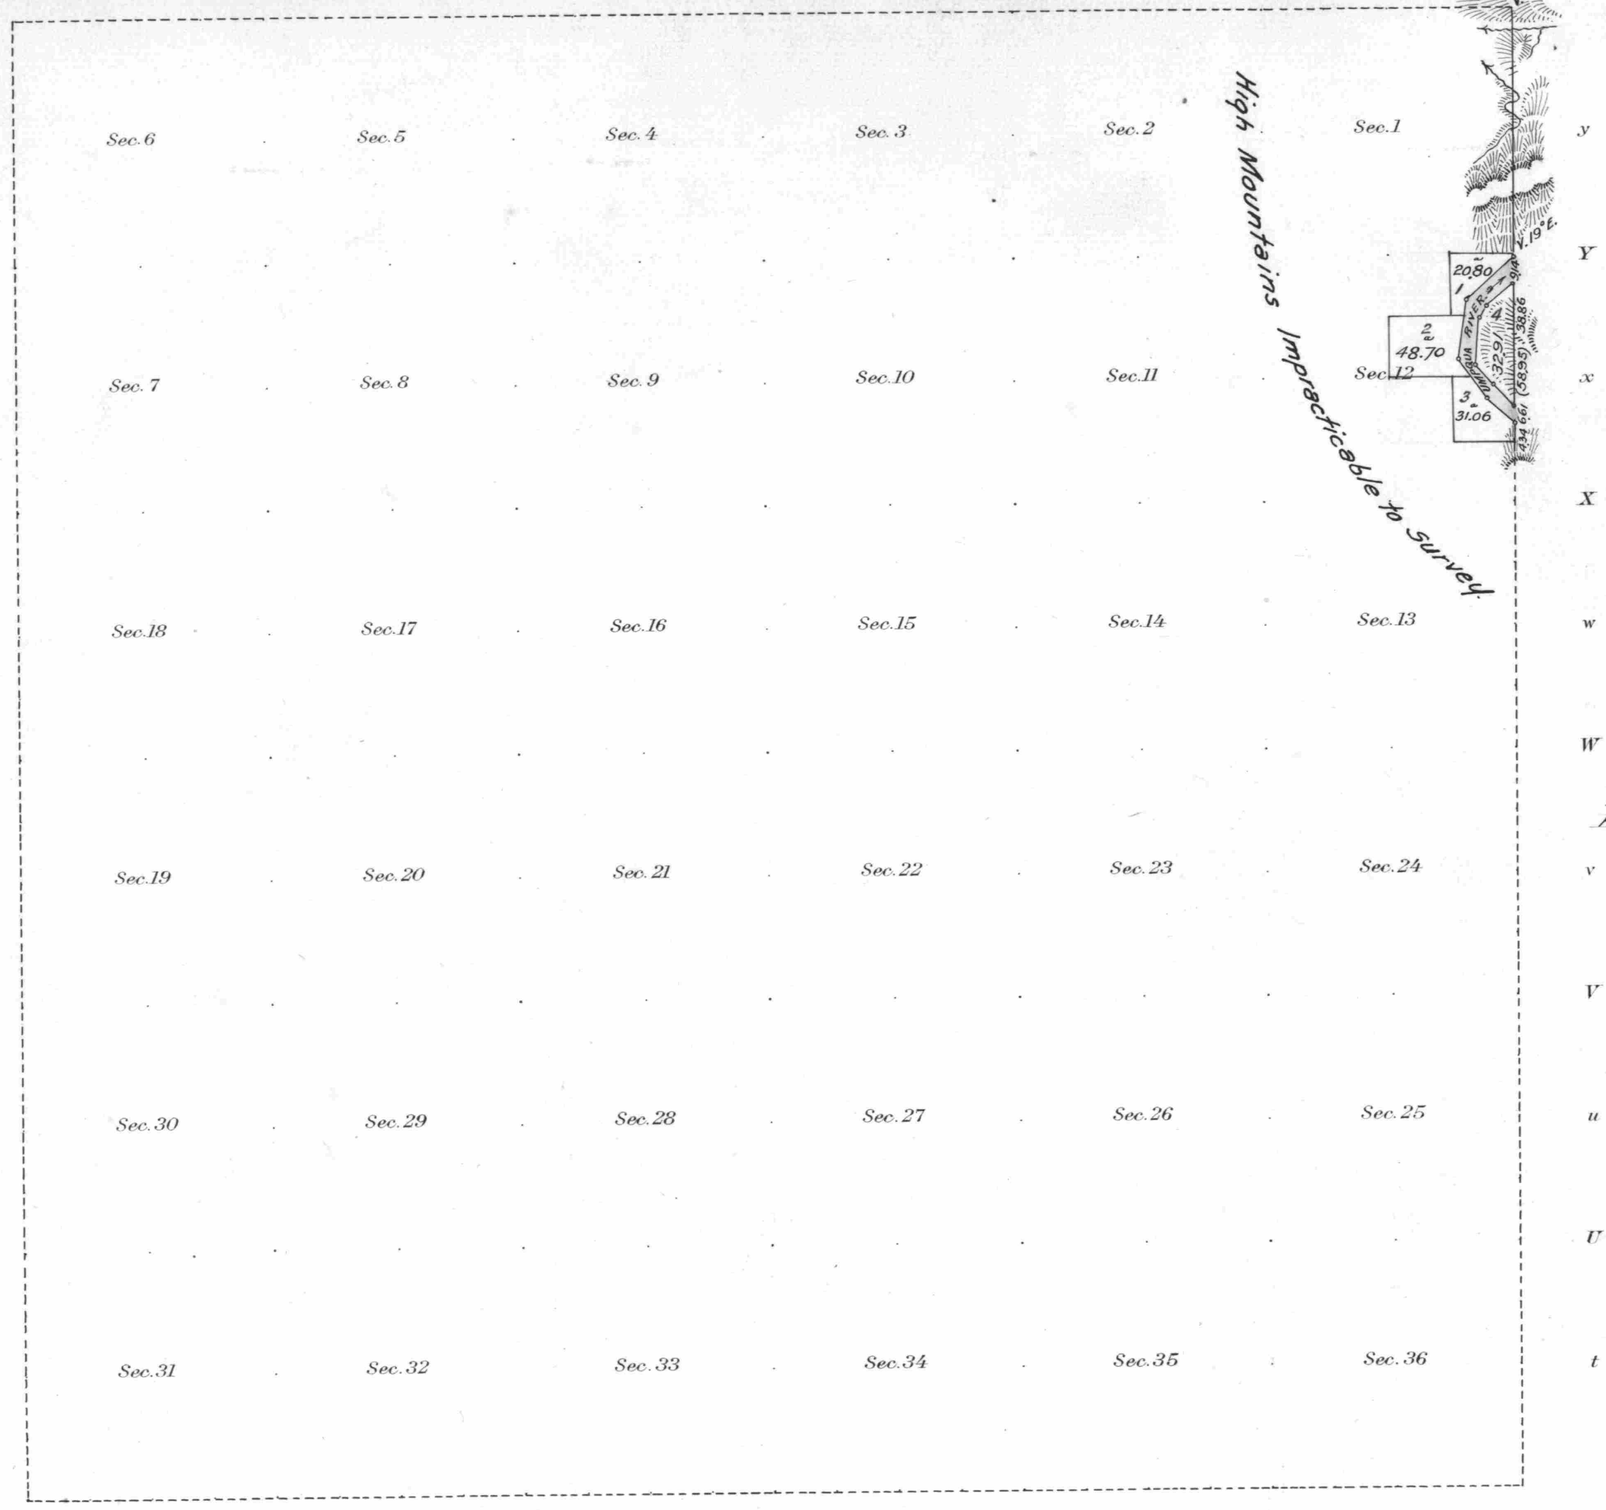

g y H Y h x I X i w K W k v L V l u M U m t N

n O o P p Q q R r S s T

I certify this to be a correct copy of the Original map on file in this office.
U.S. Surveyor General's Office.
Portland, Oregon.
April, 6. 1914
Edward L. Worth
Surveyor General.

Areas in Acres	
Public Land	
Indian Reservation	
Indian Allotments	
Mineral Claims	
Water Surface	
Total Area	

True Meridian
Var. from 19° to 19° 10' East

0 10 20 40 80

Scale 40 Chains to an inch

Mean Magnetic Declination

Surveys Designated	By Whom Surveyed	Contract No.	Contract Date	Amount of Surveys Mls.	chs.	lks.	When Surveyed	
Meanders	Dennis Hathorn	73	June. 8th 1857	01	34	45	April 24th	1858
Total number of Acres 133.47								

The above map of Fractional Township No. 25 South Range No. 8 West of the Willamette Meridian Territory of Oregon is strictly conformable to the field notes of the survey thereof on file in this office, which have been examined and approved

Surveyor General's Office.
Salem. April 24th 1858

John S. Zieber,
Surveyor General.
of Oregon.

B.