


Total number of Acres 12,528.64

SURVEYS DESIGNATED.	BY WHOM SURVEYED.	NO.	DATE OF CONTRACT.	AMOUNT OF SURVEYS.			WHEN SURVEYED.	MEAN DECLINATION.
				Miles.	Chains.	Links.		
Township Lines	A. R. and S. C. Flint	392	May 26 1881					
Subdivisions	do do do do	do	do do do do	3.5	77	51	Sept 1 <sup>st</sup> to Oct 5 1881	19° E
Retracings	do do do do	do	do do do do	5	07	20		

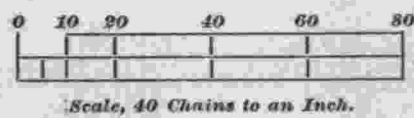

The above Map of the Subdivisions of Township No. 25 South of Range No. 8 West of the Willamette Meridian, Oregon, is strictly conformable to the Field Notes of the survey thereof on file in this Office, which have been examined and approved.

U. S. Surveyor-General's Office,  
 Portland, Oregon,  
 Jan 14, 1882. James C. Tolman  
Surveyor-General of Oregon