


ACCEPTED BY THE HON. COMMISSIONER G. L. O. May 8 1884
CASCADIA FOREST RESERVE

SURVEYS DESIGNATED.	BY WHOM SURVEYED.	NO.	DATE OF CONTRACT.	AMOUNT OF SURVEYS.			WHEN SURVEYED.	MEAN DECLINATION.
				Miles.	Chains.	Links.		
Township Lines Subdivisions	John A. McQuinn do. do. do.	466 do. do. do.	April 5 1883 do. do. do.	39	79	51	May 6 to 20. 1883.	20° 15' E.

Total number of Acres 11,510.03

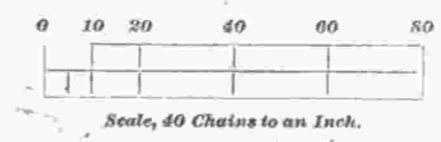

The above map of the Subdivisions of Township No. 26 South of Range No. 2 West of the Willamette Meridian, Oregon, is strictly conformable to the Field Notes of the survey thereof on file in this office, which have been examined and approved.

U. S. Surveyor-General's Office,
Portland, Oregon,
April 7, 1884 James C. Holman
Surveyor-General of Oregon.