(4-675 a)

ORIGINAL

Accepted Jan. 22, 1919 - G.L.O.

— Plat of Exteriors —

Township No. 26 South Range No. 2 West of the Willamette Meridian, Oregon

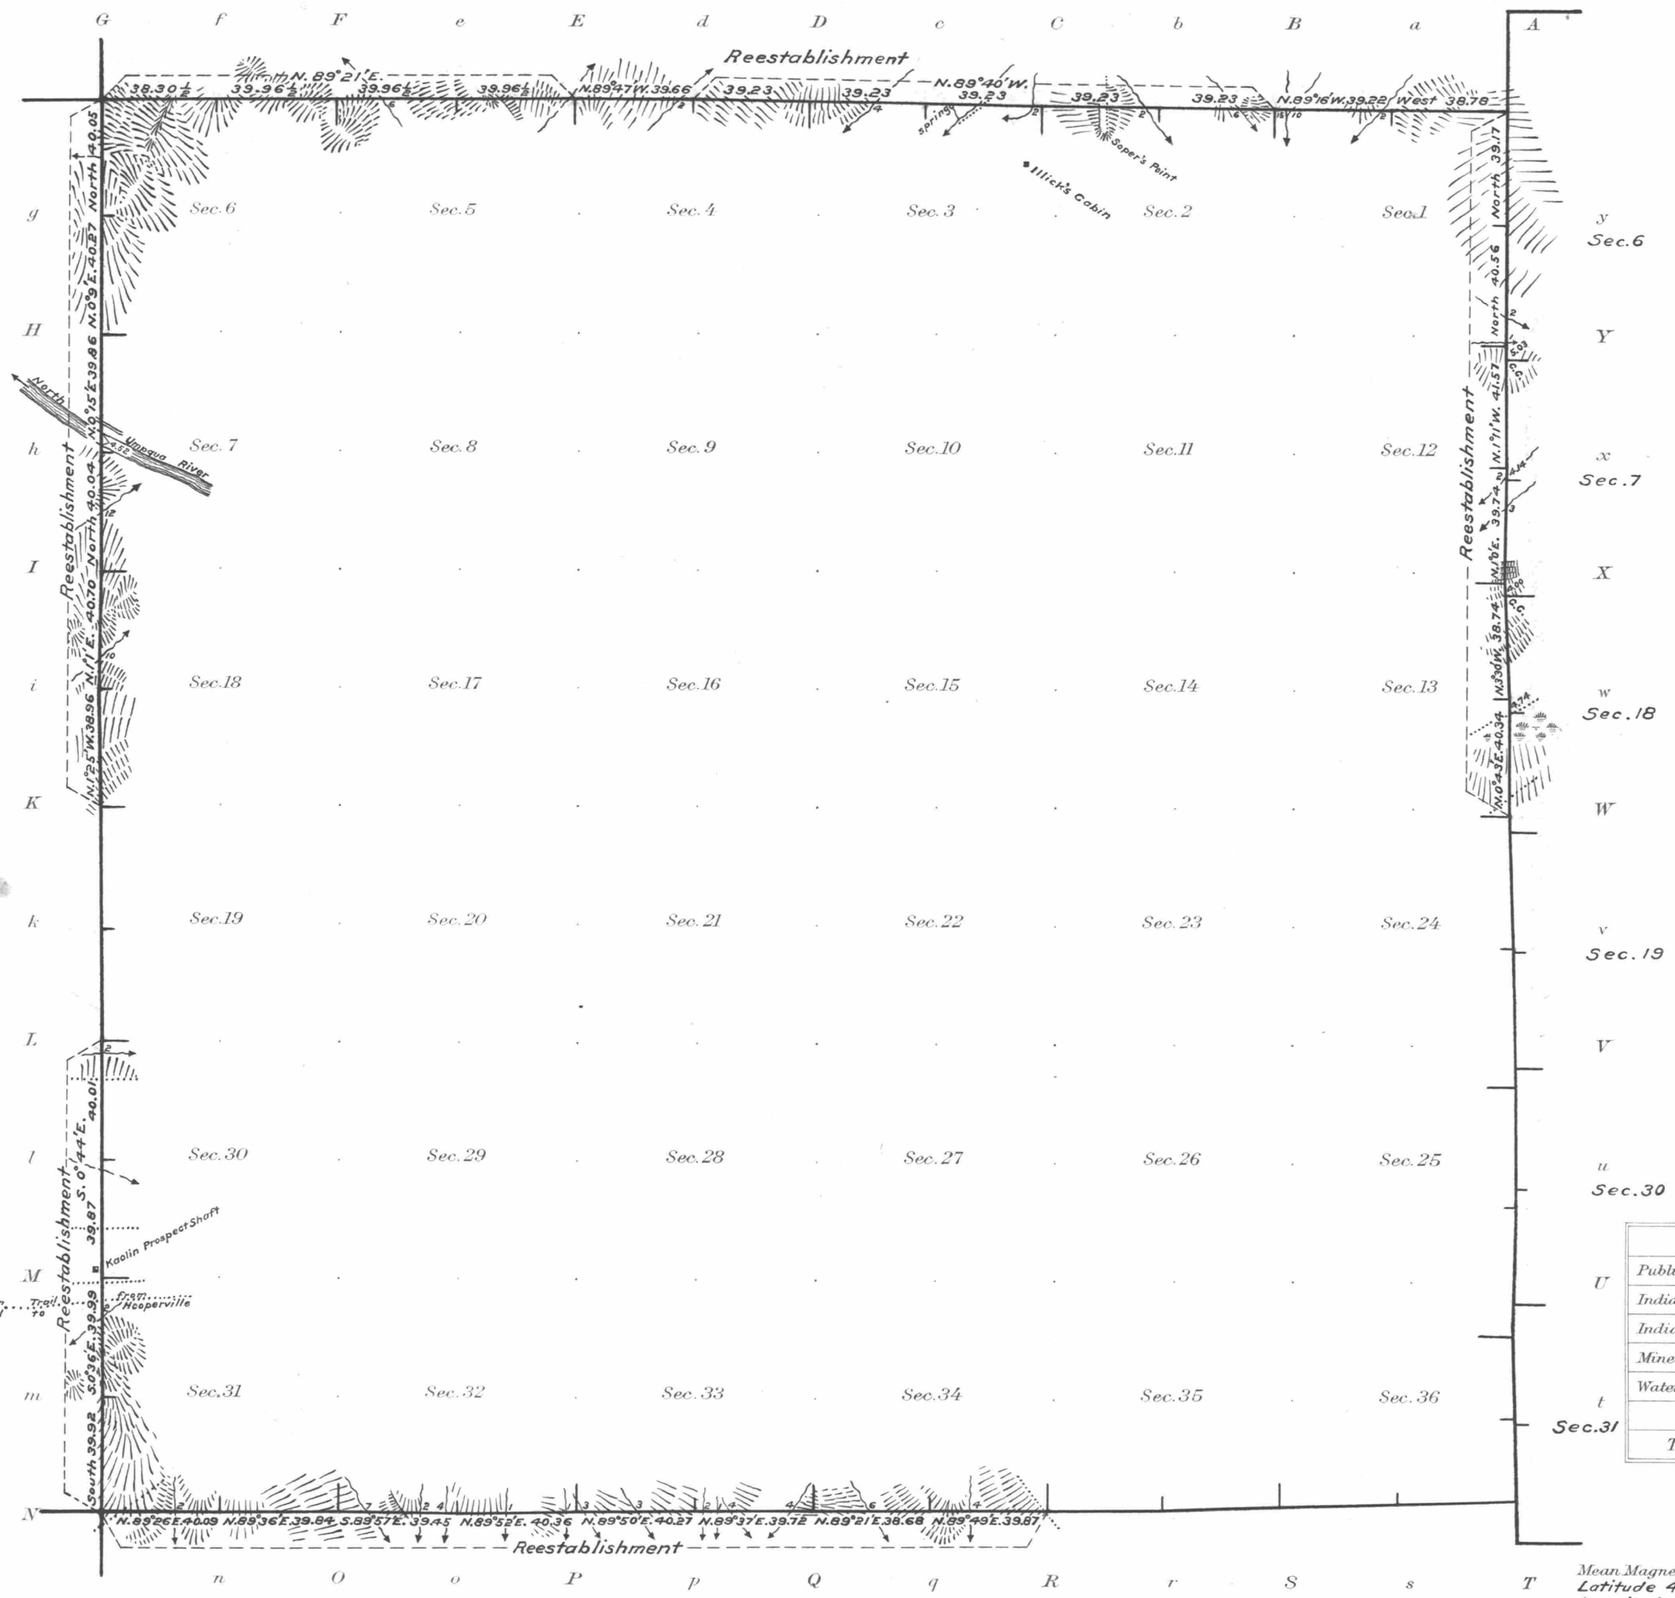

Areas in Acres	
Public Land	
Indian Reservation	
Indian Allotments	
Mineral Claims	
Water Surface	
Total Area	

True Meridian

0 10 20 40 80

Scale 40 Chains to an inch

Mean Magnetic Declination 20°30'E.
Latitude 43°17'N } At Cor. of Sec's. 19, 24, 25 & 30
Longitude 122°59'W } on W. Bdy. of Tp.

Surveys Designated	By Whom Surveyed	Group No.	Group Date of Instructions	Amount of Surveys Mls.	chs.	lks.	When Surveyed Begun	Completed
Reestablishment of	Charles M. Collier	16	May 12, 1913	17	70	08	May 28, 1913	April 11, 1914
Exterior Lines	U.S. Surveyor		Sept. 23, 1913					
Tp. and Sub. Lines	John A. McQuinn	under	Contract	466		in	1883	
Tp. and Sub. Lines	William N. Gibb	"	"	783		"	1909-10	
(See Corrective Survey	by Fred Mensch under		this Group and	Special Instructions			dated May	25, 1916)

E.C.T.

The above map of Township No. 26 South Range No. 2 West of the Willamette Meridian Oregon is strictly conformable to the field notes of the survey thereof on file in this office, which have been examined and approved

U.S. Surveyor General's Office.
Portland, Oregon, June 21, 1917

Edward Ellsworth
Surveyor General.