TOWNSHIP 26 SOUTH, RANGE 2 WEST, OF THE WILLAMETTE MERIDIAN, OREGON.

DEPENDENT RESURVEY AND SUBDIVISION OF SECTION 9

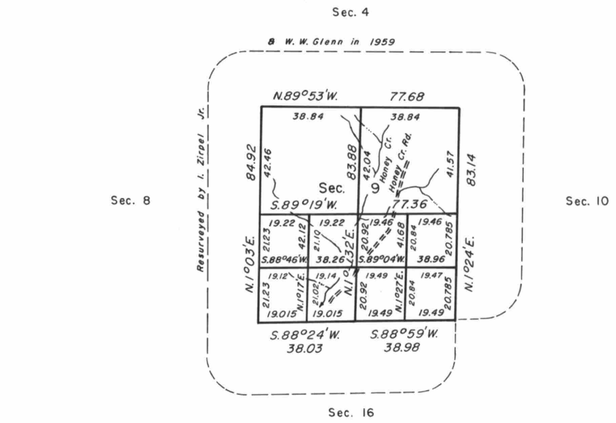

A history of surveys is contained in the field notes.

This plat represents a dependent resurvey of a portion of the south boundary and a portion of the subdivisional lines of T. 26 S., R. 2 W., Willamette Meridian, Oregon, designed to restore the corners in their true original locations according to the best available evidence, and the subdivision of section 9.

The lottings and areas are as shown on the plat approved April 7, 1884 and accepted August 29, 1960.

The survey was executed by Wayne L. Rogers, Cadastral Surveyor, beginning August 10, 1979, and completed September 17, 1979, pursuant to Special Instructions dated July 24, 1979, for Group No. 990, Oregon.

Timber in this area consists of fir, hemlock, cedar, yew, pine, madrone, ash, maple, oak, and alder.

Mean magnetic declination 19°45' East

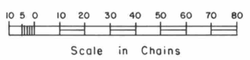

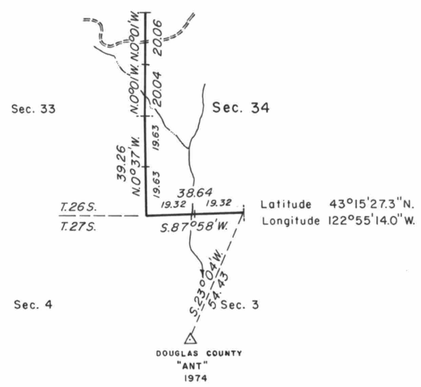

UNITED STATES DEPARTMENT OF THE INTERIOR
BUREAU OF LAND MANAGEMENT
Portland, Oregon June 16, 1983

This plat is strictly conformable to the approved field notes, and the survey, having been correctly executed in accordance with the requirements of law and the regulations of this Bureau, is hereby accepted.

For the Director

William W. Glenn

Chief Cadastral Surveyor of Oregon

rfb