5696

ORIGINAL

TOWNSHIP 26 SOUTH, RANGE 3 WEST, OF THE WILLAMETTE MERIDIAN, OREGON

DEPENDENT RESURVEY AND SURVEY

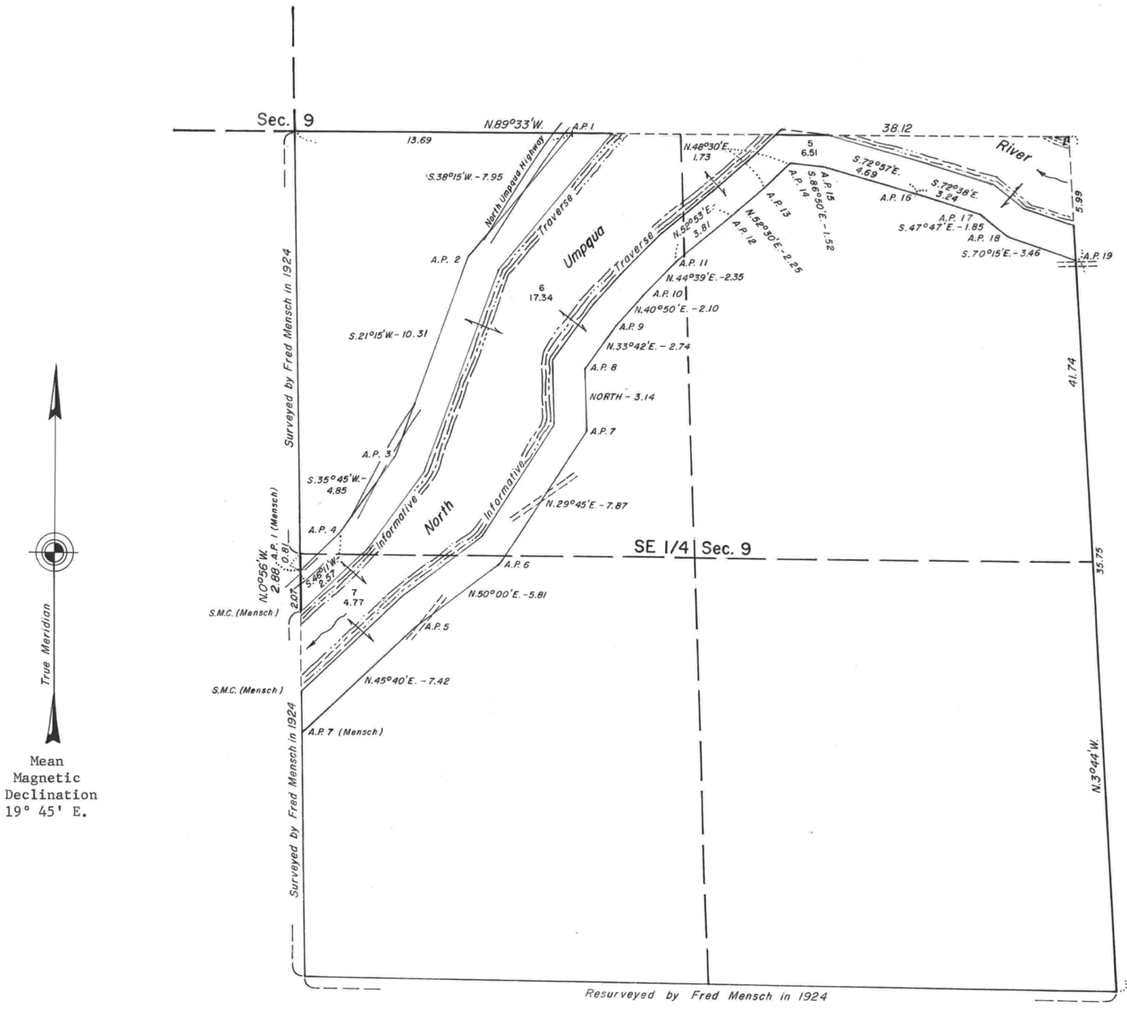

True Meridian

Mean
Magnetic
Declination
19° 45' E.

Latitude 43°18.9'N.
Longitude 123°02.9'W.

This plat represents a dependent resurvey of a portion of the subdivisional lines and subdivisions of section 9, designed to restore the corners in their true original location according to the best available evidence, and the segregation survey of certain lands in the SE¼ of section 9, T. 26 S., R. 3 W., Williamette Meridian, Oregon.

Except for new or modified vacant subdivisions as shown hereon, the lottings and areas are as shown on the plats approved December 10, 1855, February 11, 1861, March 26, 1872, October 23, 1882, and the plat accepted January 28, 1926.

Survey executed by Daniel L. Berry, Cadastral Surveyor, from September 6, 1972 to September 25, 1972, pursuant to Special Instructions for Group No. 796, Oregon, dated September 5, 1972.

LOCATION DIAGRAM

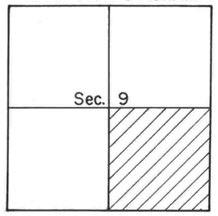

Timber in this area consists of fir, hemlock, cedar, alder, madrone, maple, oak, and chinquapin.

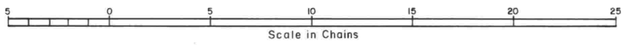

UNITED STATES DEPARTMENT OF THE INTERIOR
BUREAU OF LAND MANAGEMENT
Denver, Colorado December 6, 1979

This plat is strictly conformable to the approved field notes, and the survey, having been correctly executed in accordance with the requirements of law and the regulations of this Bureau, is hereby accepted.

For the Director

J. D. Voorhees

Chief, Cadastral Survey
Examination & Approval Staff

GEE