1119

Township No. 26 South Range No. 8 West of the Willamette Meridian Oregon

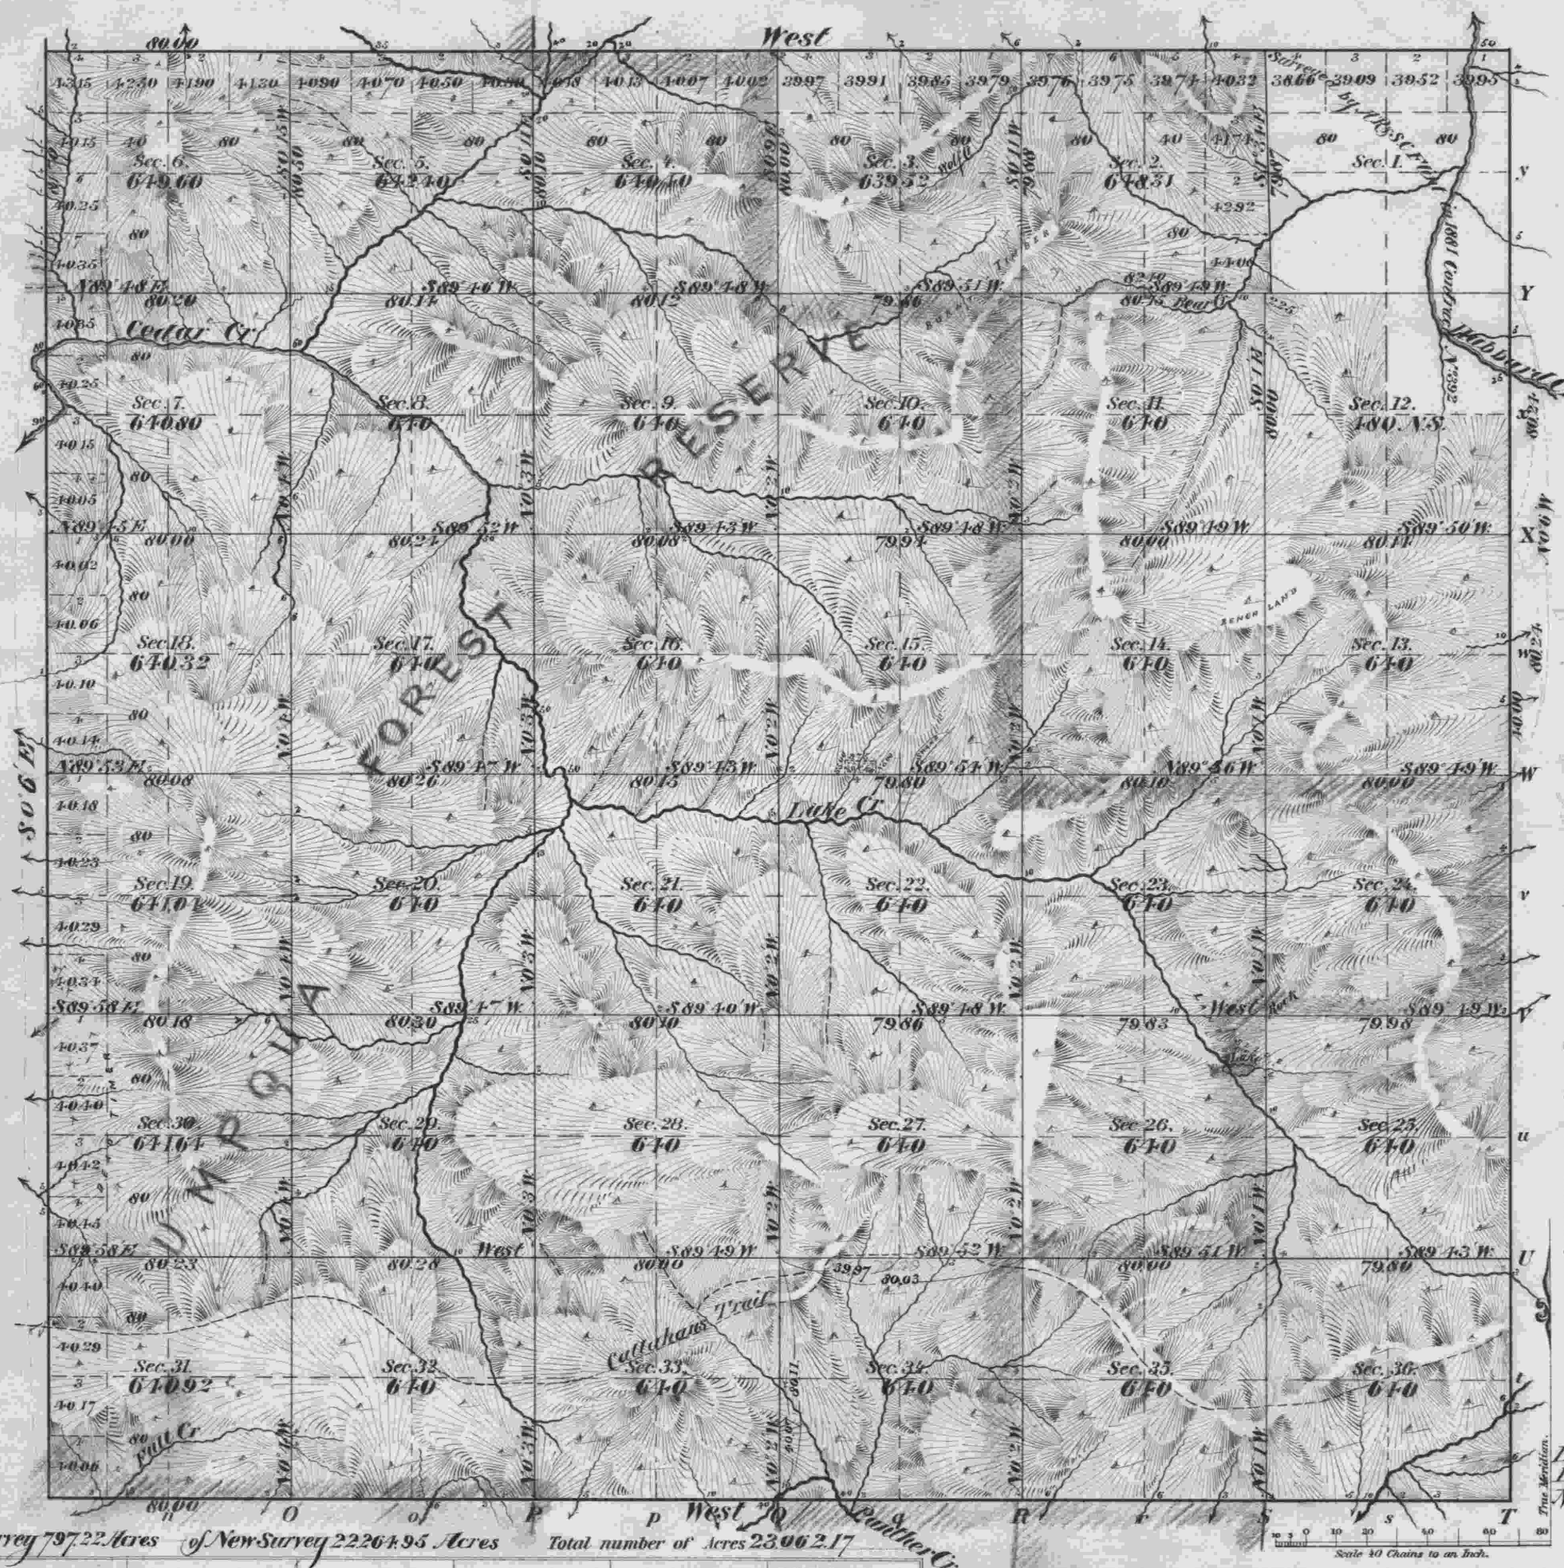


Surveys Designated	By Whom Surveyed	Date of Contract	Amount of Surveys M.	Ch.s	Lk.s	When Surveyed	No. of Contract
Township lines							
Subdivisions	William P. Hayden	May 21 1896	58	04	54	Sep. 14 to Oct. 23 1896	656
Connections	" " "	" "		2	25		
North South East & West Bd.ries of Tp	A. Rand & S. C. Flint	May 26 1881				1881	392
Re-survey of W. Bdry	John W. Meldrum	May 21 1896				1896	662

Latitude 43° 15' N.
Longitude 123° 34' W.
Mean mag. dec'l 20° 15' E.

True Meridian.

Meanders of

Posts	Courses	Ch.s Lk.s	Posts	Courses	Ch.s Lk.s	Posts	Courses	Ch.s Lk.s

ACCEPTED BY THE HON. COMMISSIONER G. L. O. December 7. 1898

The above Map, of Township No. 26 South of Range No. 8 West of the Willamette Meridian, Oregon, is strictly conformable to the field notes of the survey thereof on file in this Office, which have been examined and approved.

Surveyor General's Office, Portland Oregon Sep. 10 1897

Robert A. Habersham
Sur. Gen. for Oregon

The above map of Township No. 26 South, of Range No. 8 West of the Willamette Meridian Oregon, has been amended and is strictly conformable to the field notes of the corrected survey thereof on file in this office, which have been examined and approved.

Surveyor General's Office, Portland Oregon, Oct. 29, 1898

Robert A. Habersham
Sur. Gen. for Oregon.