TOWNSHIP 26 SOUTH, RANGE 9 WEST, OF THE WILLAMETTE MERIDIAN, OREGON.

CORNER REMONUMENTATION WITHOUT SURVEY

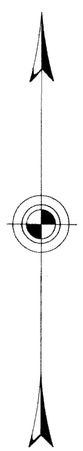

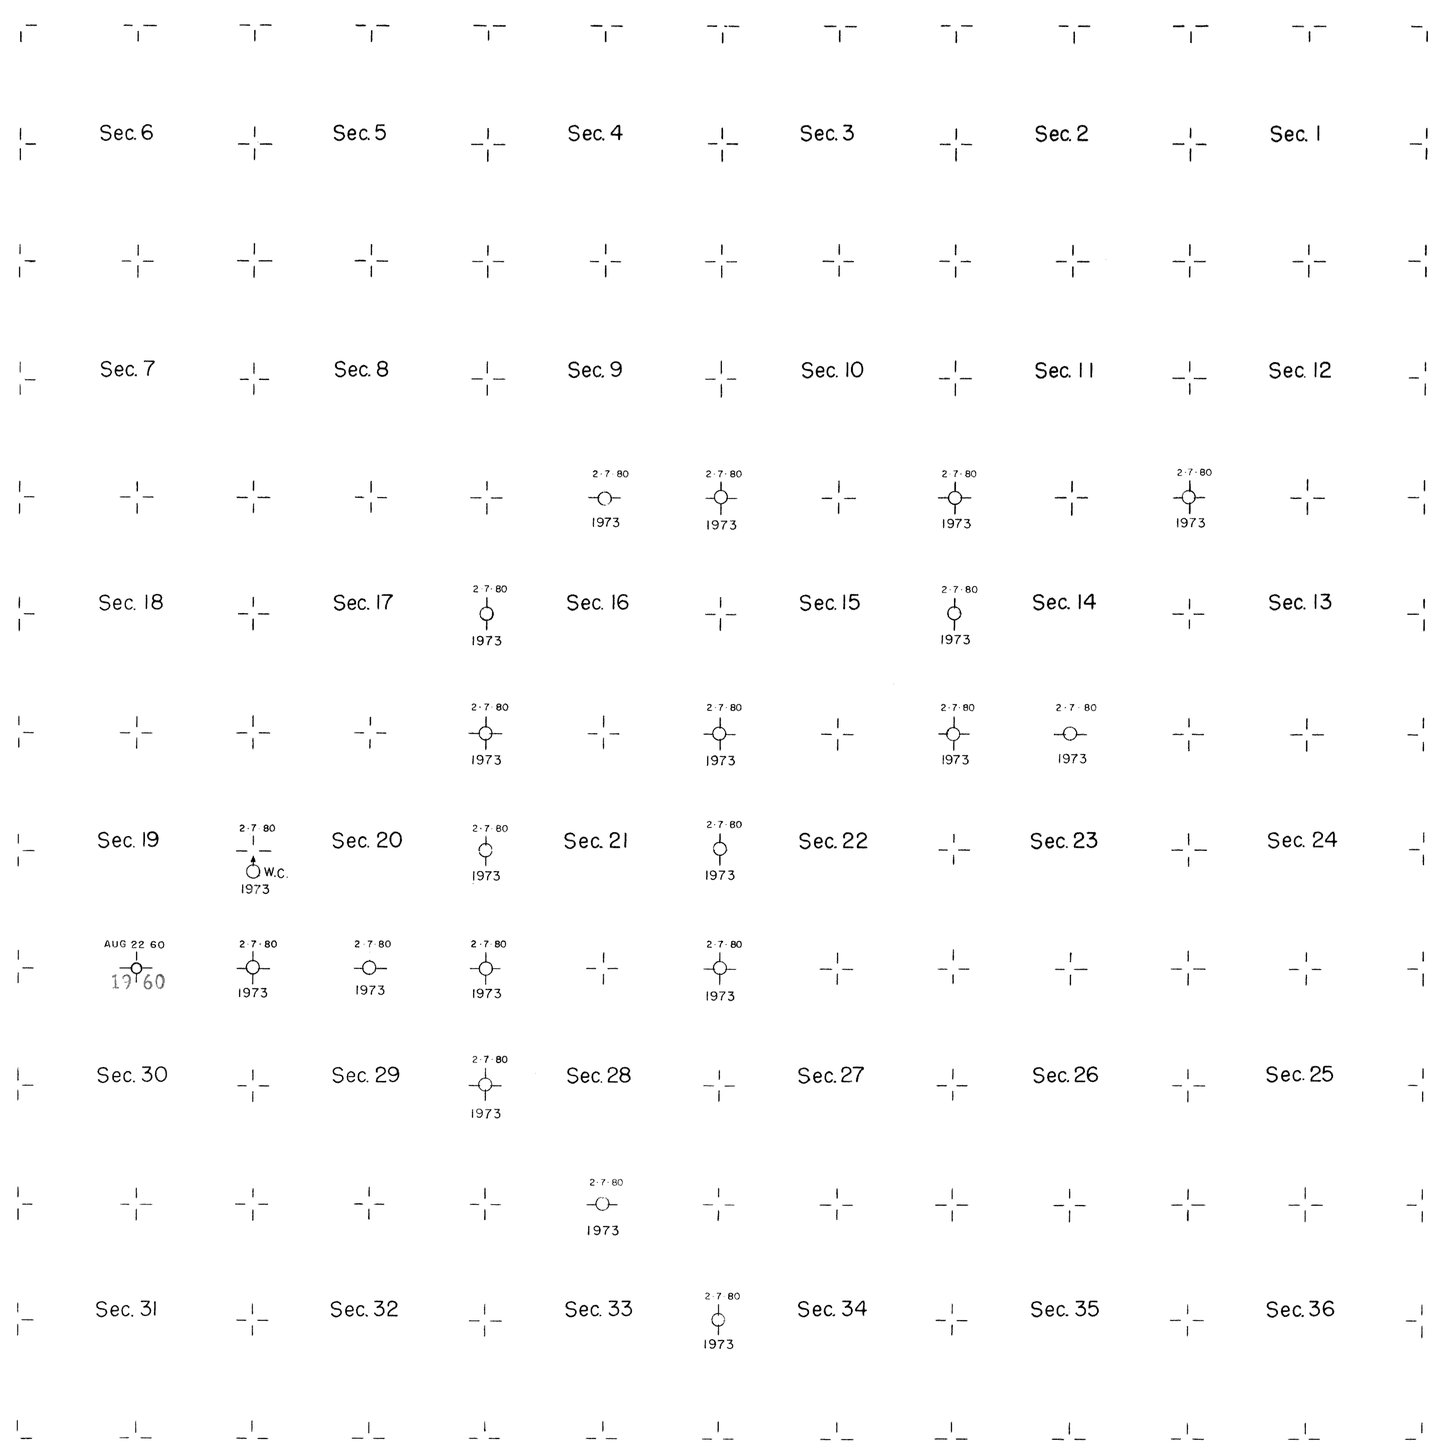

LEGEND

Date Approved
Date On Cap

Disclaimer:
This document is not an official survey. It serves as an index to corners of the Public Land Survey System which have been remonumented or rehabilitated. Refer to the approved field notes for official information.