5511

ORIGINAL

TOWNSHIP 27 SOUTH, RANGE 1 WEST, OF THE WILLAMETTE MERIDIAN, OREGON.

DEPENDENT RESURVEY

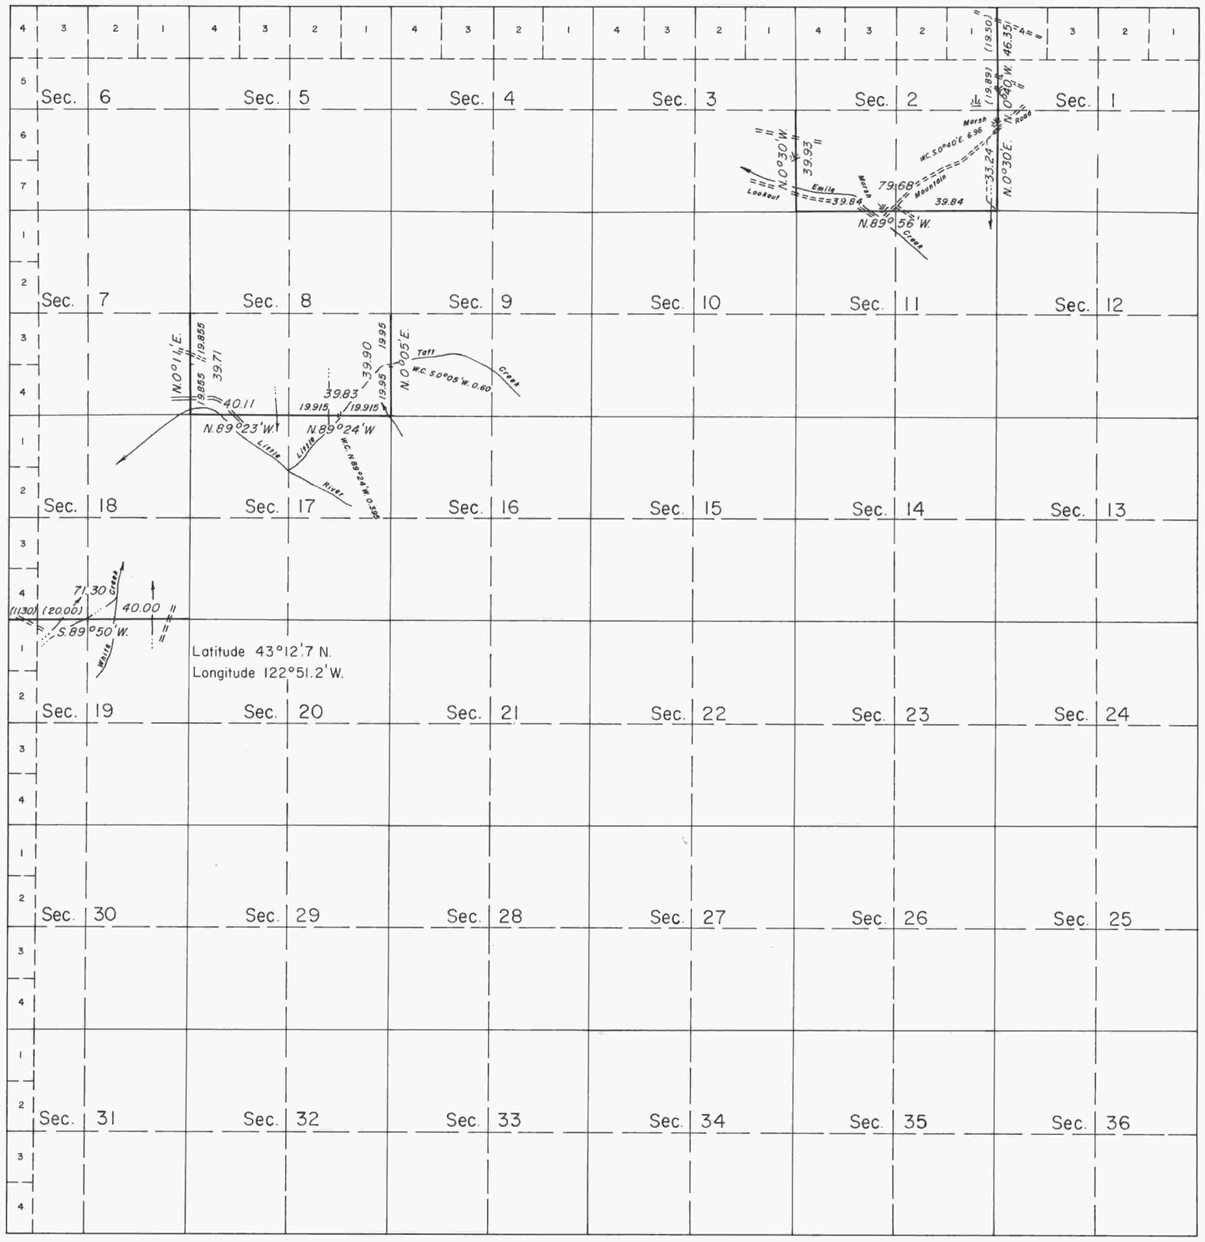

True Meridian

Mean magnetic declination 20° East

This plat represents a retracement and reestablishment of a portion of the subdivisional lines T. 27 S., R. 1 W., Willamette Meridian, Oregon designed to restore all corners in their true original location according to the best available evidence.

In 1882, Samuel C. Flint surveyed the west boundary. In 1902, Homer D. Angell surveyed the north boundary and retraced or resurveyed the west boundary. In 1910, Fred Mensch resurveyed the north boundary, at which time corners of minimum control were established for T. 26 S., R. 1 W. In 1911, Morris Wygant under the supervision of Z.M. Derrick retraced the south four miles of the west boundary.

The lottings and areas are as shown on the plat approved February 17, 1904.

This resurvey was executed by Jasper M. Sams and Donevan C. Harris, Cadastral Surveyors, June 30, 1971 to August 2, 1971 pursuant to Special Instructions dated June 23, 1971 which provide for the surveys under Group No. 747, Oregon.

UNITED STATES DEPARTMENT OF THE INTERIOR
BUREAU OF LAND MANAGEMENT
Washington, D.C. December 29, 1972

This plat is strictly conformable to the approved field notes, and the survey, having been correctly executed in accordance with the requirements of law and the regulations of this Bureau, is hereby accepted.

For the Director

Clark L. Gumm

Chief, Division of Cadastral Survey

"SUSPENDED May 22, 1980, File 9650.12 (D-401)"

"SUSPENSION LIFTED: October 30, 1981, File 9650.12 (D-401)"

10 5 0 10 20 30 40 50 60 70 80
Chains

Timber in this area consists of Douglas and white fir, pine, cedar and hemlock.

Jo (wo)