247

Township No. 27 South Range No. 2 West of the Willamette Meridian Oregon

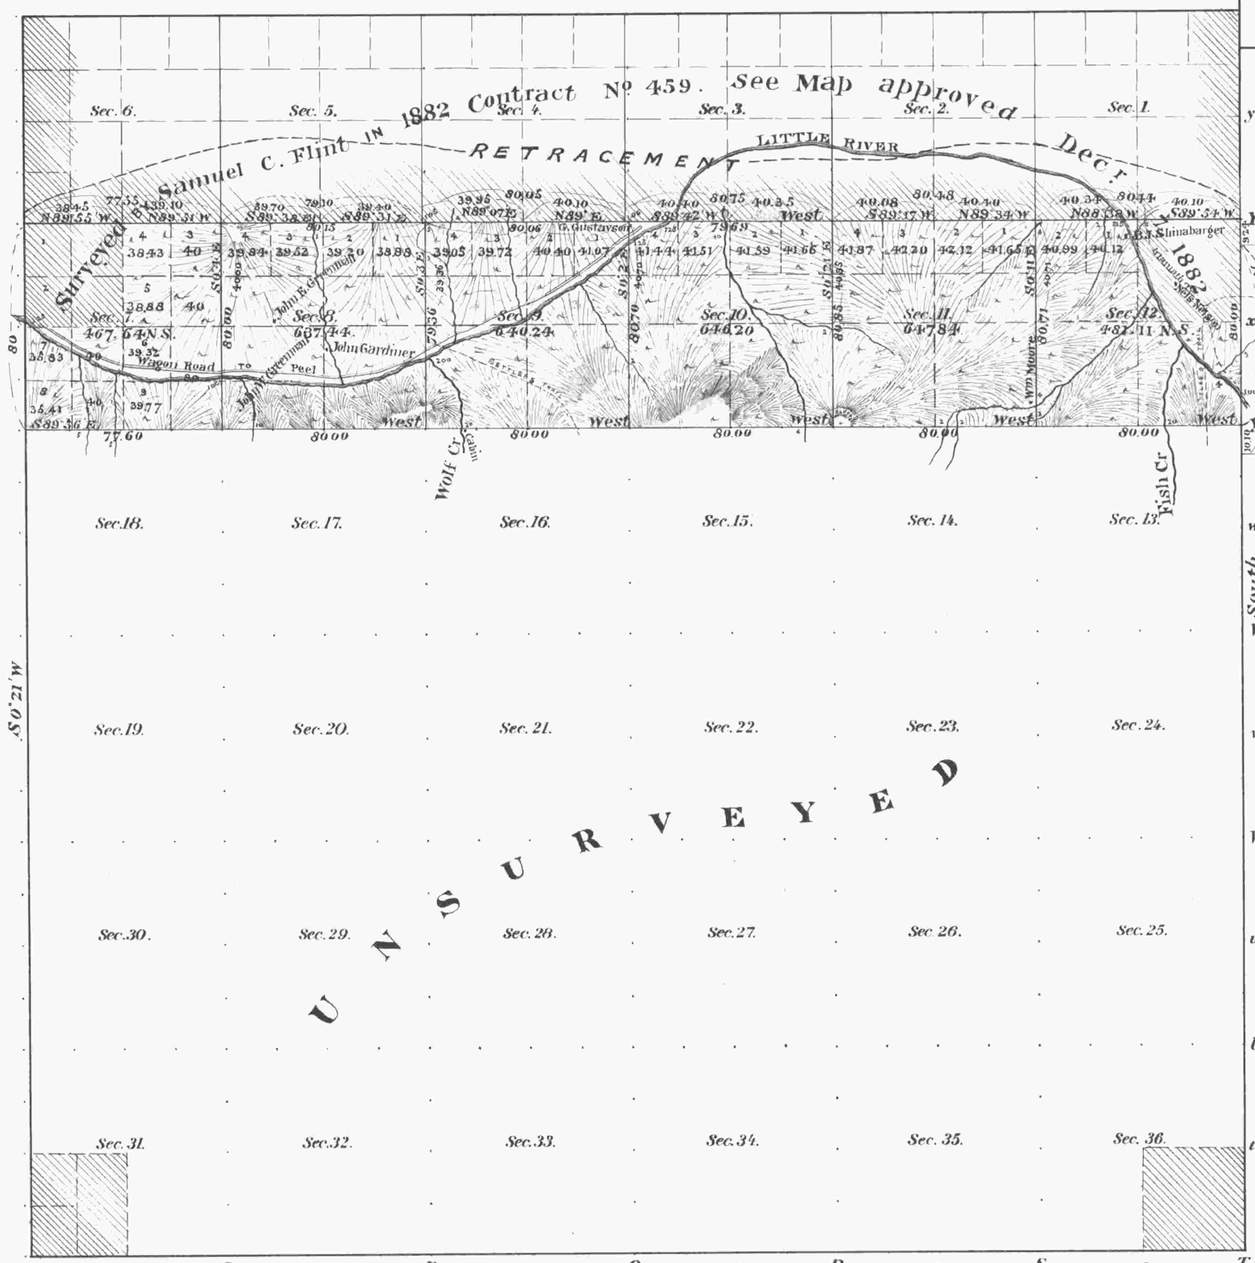

Meanders of

Posts	Courses	Ch.s Lk.s	Posts	Courses	Ch.s Lk.s	Posts	Courses	Ch.s Lk.s

Map of 1908

The above Map of Township No. 27 South, Range No. 2 West of the Will Mer Oregon, has been amended to conform to the supplemental field notes of the amended surveys and retracements made by Charles E. Roberts D.S. on file in this office which have been examined and approved made by order of the Hon Commissioner's Letter "E" dated April 13th 1907.

Surveyor Generals Office
Portland, Oregon Jan.y 23. 1908 } Geo A Mesloh
Sur.r Gen.l for Oregon

ACCEPTED BY THE HON. COMMISSIONER G. L. O.

Latitude 45° 15' N
Longitude 122° 32' W } At cor of Secs 1, 2, 11 and 12.
Mean Mag Decl 20° 10' E.

Area of Former Survey 4518.73 Acres — of New Survey 3520.47 Acres Total number of Acres 8039.20

Surveys Designated	By Whom Surveyed	Date of Contract	Amount of Surveys M.	Ch.s	Lk.s	When Surveyed	No. of Contract
Township lines, Resurvey of E. Bdy of Sec 12	Charles E. Roberts	Oct. 26. 1904	1.	00	00	July 14 and 15. 1905	759.
Subdivisions	" " "	" " "	10	79	22	July 14. 1905 & Sep.t 4. 1907	"
Retracement of N. Bd.ries of Secs 7, 8, 10, 11, and 12.	" " "	" " "	5	78	37	- - - - - -	"
Connections	" " "	" " "		2/10	11/10		"
Resurvey of E. Bdy of Secs 12, 13, 24, 25 & 36	Homer D. Angell	May 5. 1902				1902	746
N. S. and E. Bd.ries	Samuel C. Flint	Aug. 3. 1882				1882	459
J.W. W. Bd.y of Tp.	" " "	June 19. 1882				1882	454.

The above Map of Township No. 27 South, of Range No. 2 West of the Willamette Meridian Oregon, is strictly conformable to the field notes of the survey thereof on file in this Office, which have been examined and approved.

Surveyor Generals Office.
Portland Oregon Mar. 6. 1906 } Jno W Dailey
Sur. Gen.l for Oregon