5701

ORIGINAL

TOWNSHIP 27 SOUTH, RANGE 2 WEST, OF THE WILLAMETTE MERIDIAN, OREGON.

CORRECTIVE DEPENDENT RESURVEY

Sec. 33

Sec. 34

Sec. 35

Sec. 4

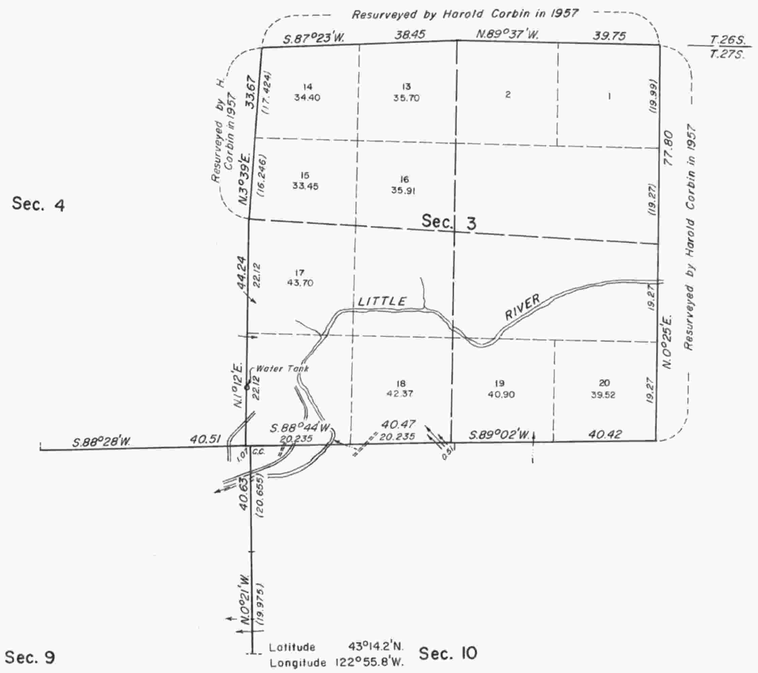

Sec. 2

A history of surveys is contained in the field notes.

This plat represents a corrective dependent resurvey of a portion of the subdivisional lines, T. 27 S., R. 2 W., Willamette Meridian, Oregon, designed to restore the corners in their true original locations according to the best available evidence.

Except as shown hereon, the lottings and areas are as shown on the plat approved December 7, 1882.

Corrective dependent resurvey executed by James E. Jelley, Cadastral Surveyor, from April 20, 1978, to May 3, 1978, under Special Instructions dated June 21, 1957, and Supplemental Special Instructions dated March 13, 1978, which provided for the surveys included under Group No. 351, Oregon.

Mean magnetic declination 19° 30' E.

Sec. 9

Sec. 10

Sec. 11

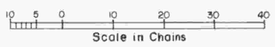

UNITED STATES DEPARTMENT OF THE INTERIOR
BUREAU OF LAND MANAGEMENT
Denver, Colorado January 28, 1980

This plat is strictly conformable to the approved field notes, and the survey, having been correctly executed in accordance with the requirements of law and the regulations of this Bureau, is hereby accepted.

For the Director

J. D. Voorhees

Chief, Cadastral Survey
Examination and Approval Staff

Timber in this area consists of fir, hemlock, cedar, pine, madrone, and maple.

GEE

LD#