TOWNSHIP 27 SOUTH, RANGE 3 WEST, OF THE WILLAMETTE MERIDIAN, OREGON

DEPENDENT RESURVEY AND SUBDIVISION OF SECTIONS

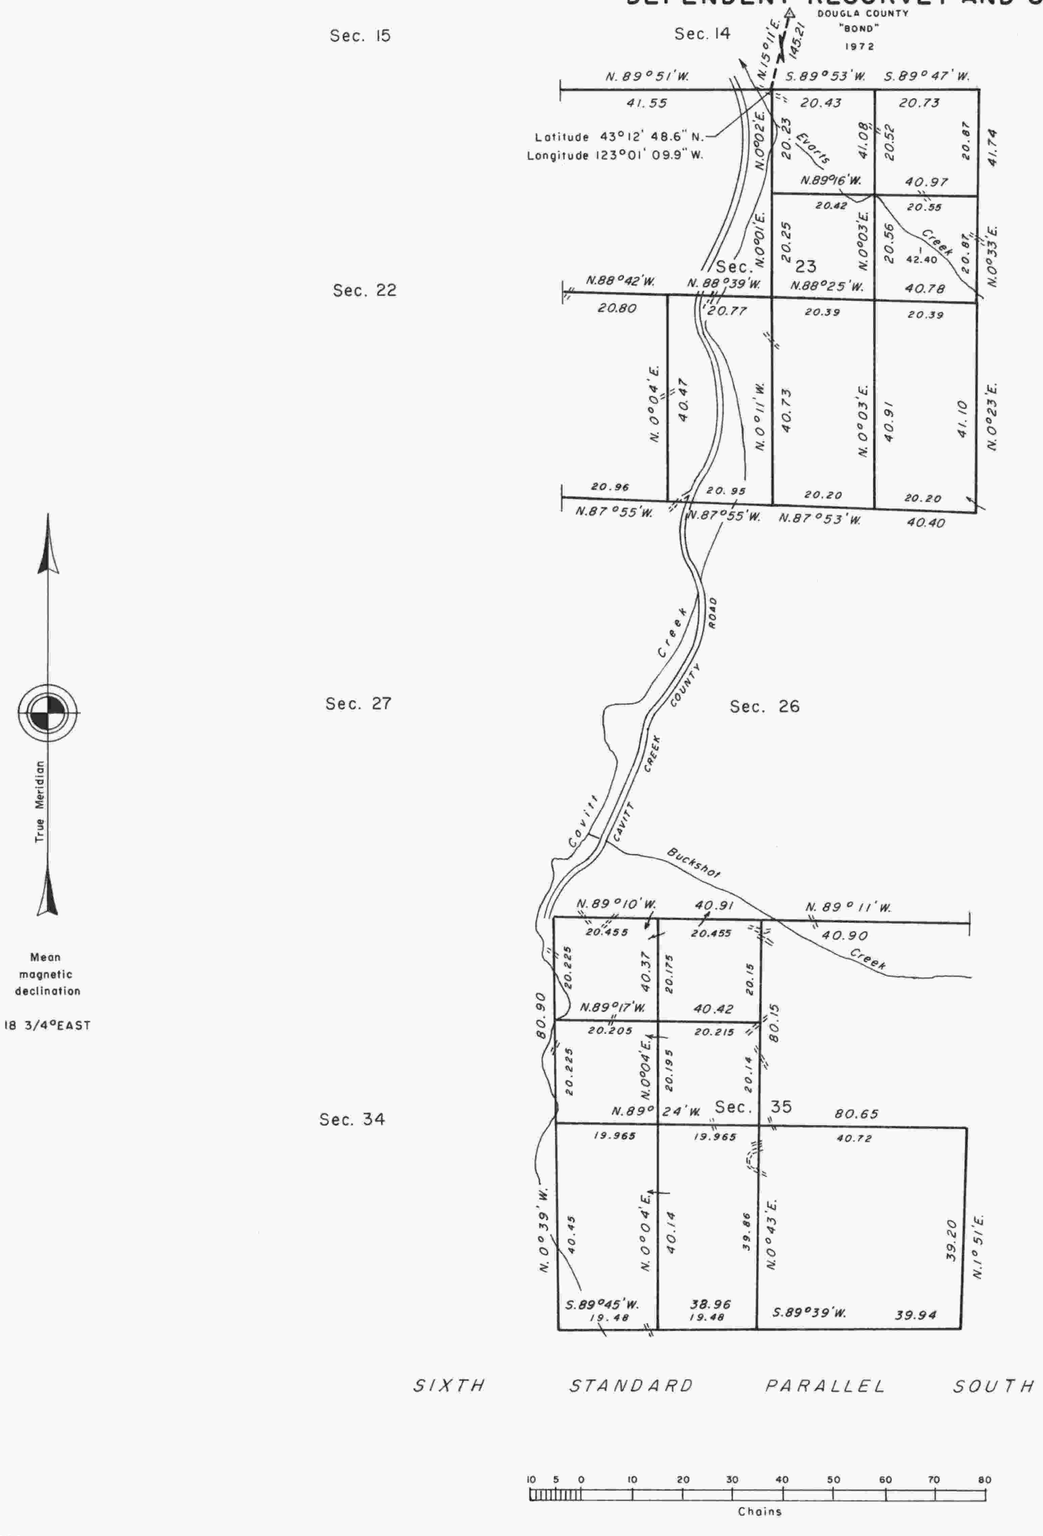

The history of surveys is contained in the field notes.

This plat represents a dependent resurvey of a portion of the south boundary (Sixth Standard Parallel South), and subdivisional lines, T. 27 S., R. 3 W., Willamette Meridian, Oregon, designed to restore the corners in their true original locations according to the best available evidence, and the subdivision of sections 23 and 35.

Except as shown hereon, the lottings and areas are as shown on the plat approved October 23, 1882.

The survey was executed by Boyd W. Peterson and Mark D. Dixon, Cadastral Surveyors, beginning May 1, 1985, and completed September 10, 1985, pursuant to Special Instructions dated April 19, 1985, under Group Number 1268, Oregon.

Timber in this area consists of fir, hemlock, cedar, oak, madrone, maple, pine, and chinquapin.

UNITED STATES DEPARTMENT OF THE INTERIOR
BUREAU OF LAND MANAGEMENT
Portland, Oregon April 7, 1988

This plat is strictly conformable to the approved field notes, and the survey, having been correctly executed in accordance with the requirements of law and the regulations of this Bureau, is hereby accepted.

For the Director

Daniel Z. Berry

Acting Chief Cadastral Surveyor of Oregon

USA?