ORIGINAL

TOWNSHIP 27 SOUTH, RANGE 3 WEST, OF THE WILLAMETTE MERIDIAN, OREGON

RETRACEMENT

FILED
Date: 11/17/2009 By: JC
This survey consists of:
~~Map:~~ BLM FIELD NOTES
~~Narrative:~~ VOL. 56
~~Corner Rpt.~~ PGS. 21828-37
DOUGLAS COUNTY SURVEYOR

OFFICIALLY FILED:

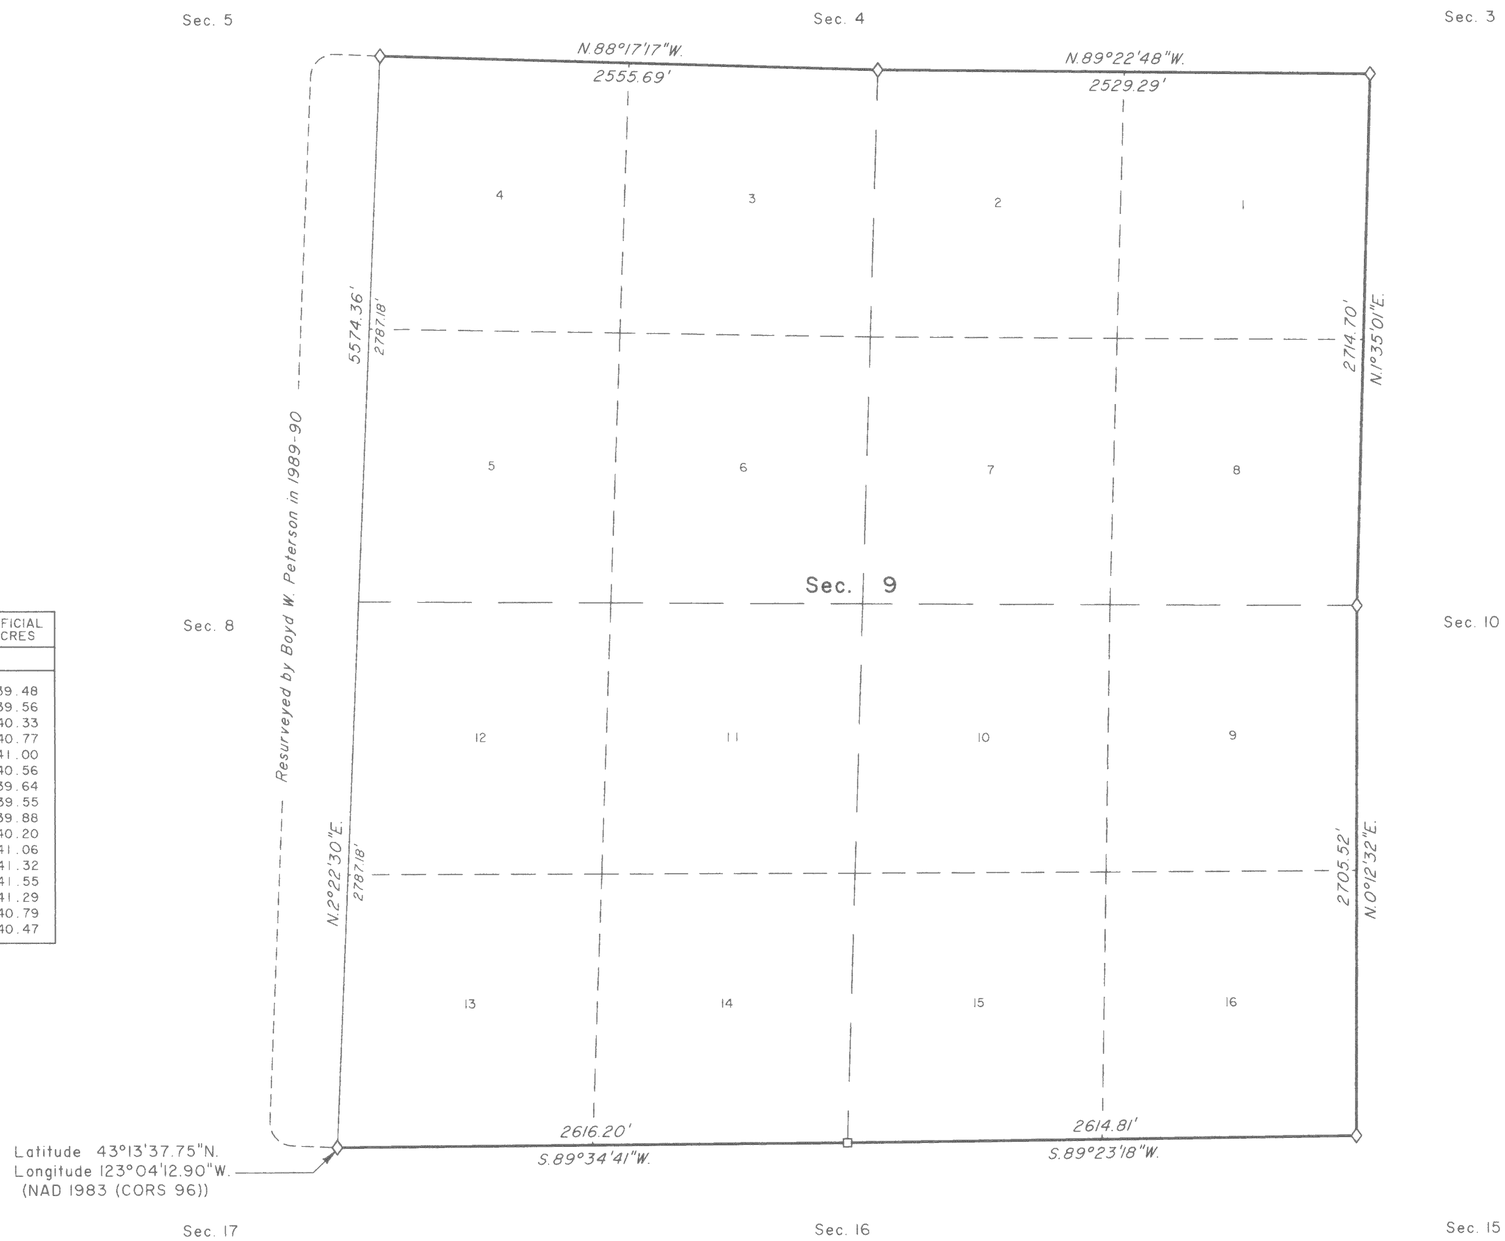

LEGAL SUBDIVISION	OFFICIAL ACRES
SECTION 9	
LOT 1	39.48
LOT 2	39.56
LOT 3	40.33
LOT 4	40.77
LOT 5	41.00
LOT 6	40.56
LOT 7	39.64
LOT 8	39.55
LOT 9	39.88
LOT 10	40.20
LOT 11	41.06
LOT 12	41.32
LOT 13	41.55
LOT 14	41.29
LOT 15	40.79
LOT 16	40.47

Scale in Feet

A history of surveys is contained in the field notes.

This plat represents the retracement of a portion of the subdivisional lines, T. 27 S., R. 3 W., Willamette Meridian, Oregon, designed to restore the corners in their true original locations according to the best available evidence.

Measured distances and directions have been adjusted by computer software that incorporates a least squares adjustment routine. The adjusted bearings and distances are reported to the nearest second and 0.01 foot.

Actual quantity acreages have been returned for the federal interest lands where indicated. The lots will retain their designation even though the official acreage has changed. When an area has been assigned a lot number, it may be further subdivided only by a supplemental plat or another official survey. The official lottings and areas of federal interest lands not affected by this survey are as shown on the plat approved October 23, 1882.

The survey was executed by A. Bert Skeesick, Cadastral Surveyor, and Robert H. Browning, Surveying Technician, beginning March 13, 2008, and completed April 12, 2008, pursuant to Special Instructions dated March 16, 2007, under Group Number 2300, Oregon.

LEGEND

◇ Original corner previously remonumented

□ Corner previously established or reestablished

UNITED STATES DEPARTMENT OF THE INTERIOR
BUREAU OF LAND MANAGEMENT

Portland, Oregon

The retracement represented by this plat, having been correctly executed in accordance with the requirements of law and the regulations of this Bureau, is hereby accepted.

For the Director

Mary J. M. Hunter

Chief Cadastral Surveyor of Oregon

September 4, 2009
Date

D.C.W.