5478

ORIGINAL

TOWNSHIP 27 SOUTH, RANGE 4 WEST, OF THE WILLAMETTE MERIDIAN, OREGON.

DEPENDENT RESURVEY

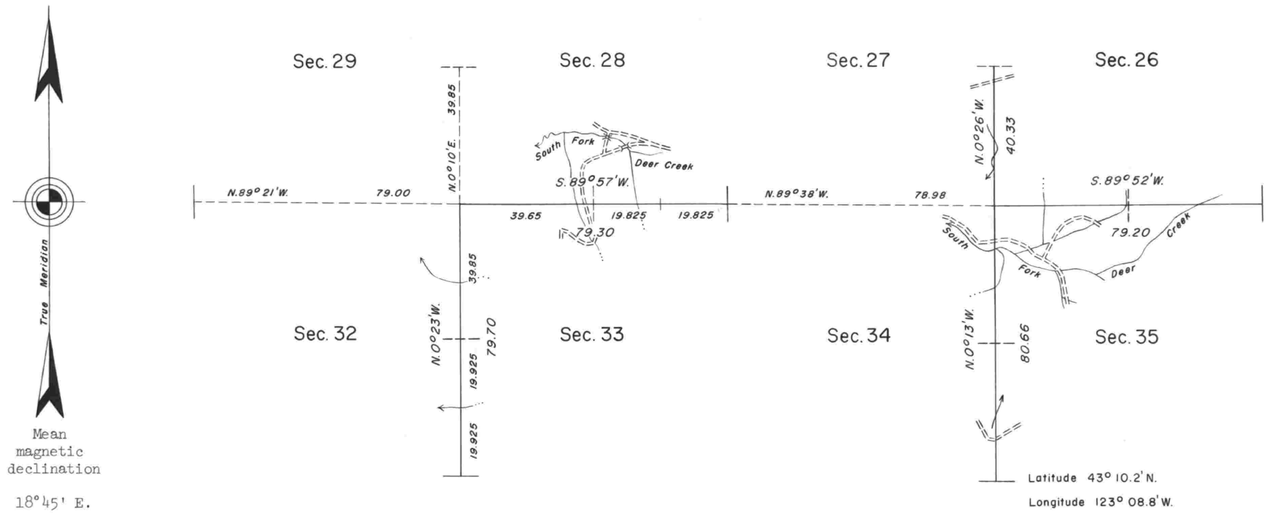

This plat represents a retracement and reestablishment of a portion of the subdivisional lines, T. 27 S., R. 4 W., Willamette Meridian, Oregon, designed to restore the corners in their true original locations according to the best available evidence.

Nathaniel Ford surveyed the Sixth Standard Parallel South (South boundary of township) in 1854. Addison R. Flint independently resurveyed the Sixth Standard Parallel South and subdivided a portion of the township in 1855. William H. Byars retraced the Sixth Standard Parallel South in 1881. Elmer F. Strickler completed the subdivision of the township in 1917. Irving Zirpel, Jr. and William W. Glenn dependently resurveyed a portion of the Sixth Standard Parallel South in 1958.

The resurvey was executed by James E. Jelley, Cadastral Surveyor, from April 3 to April 24, 1970 under Special Instructions dated March 19, 1970, which provide for the surveys included under Group No. 700, Oregon.

UNITED STATES DEPARTMENT OF THE INTERIOR
BUREAU OF LAND MANAGEMENT
Washington, D.C. December 27, 1971

This plat is strictly conformable to the approved field notes, and the survey, having been correctly executed in accordance with the requirements of law and the regulations of this Bureau, is hereby accepted.

For the Director

Clark I. Humm

Chief, Division of Cadastral Survey

Timber in this area consists of fir, hemlock, cedar, alder, maple, and dogwood.

SGW-