


Township No. 27 South Range No. 7 West of the Willamette Meridian, Oregon.

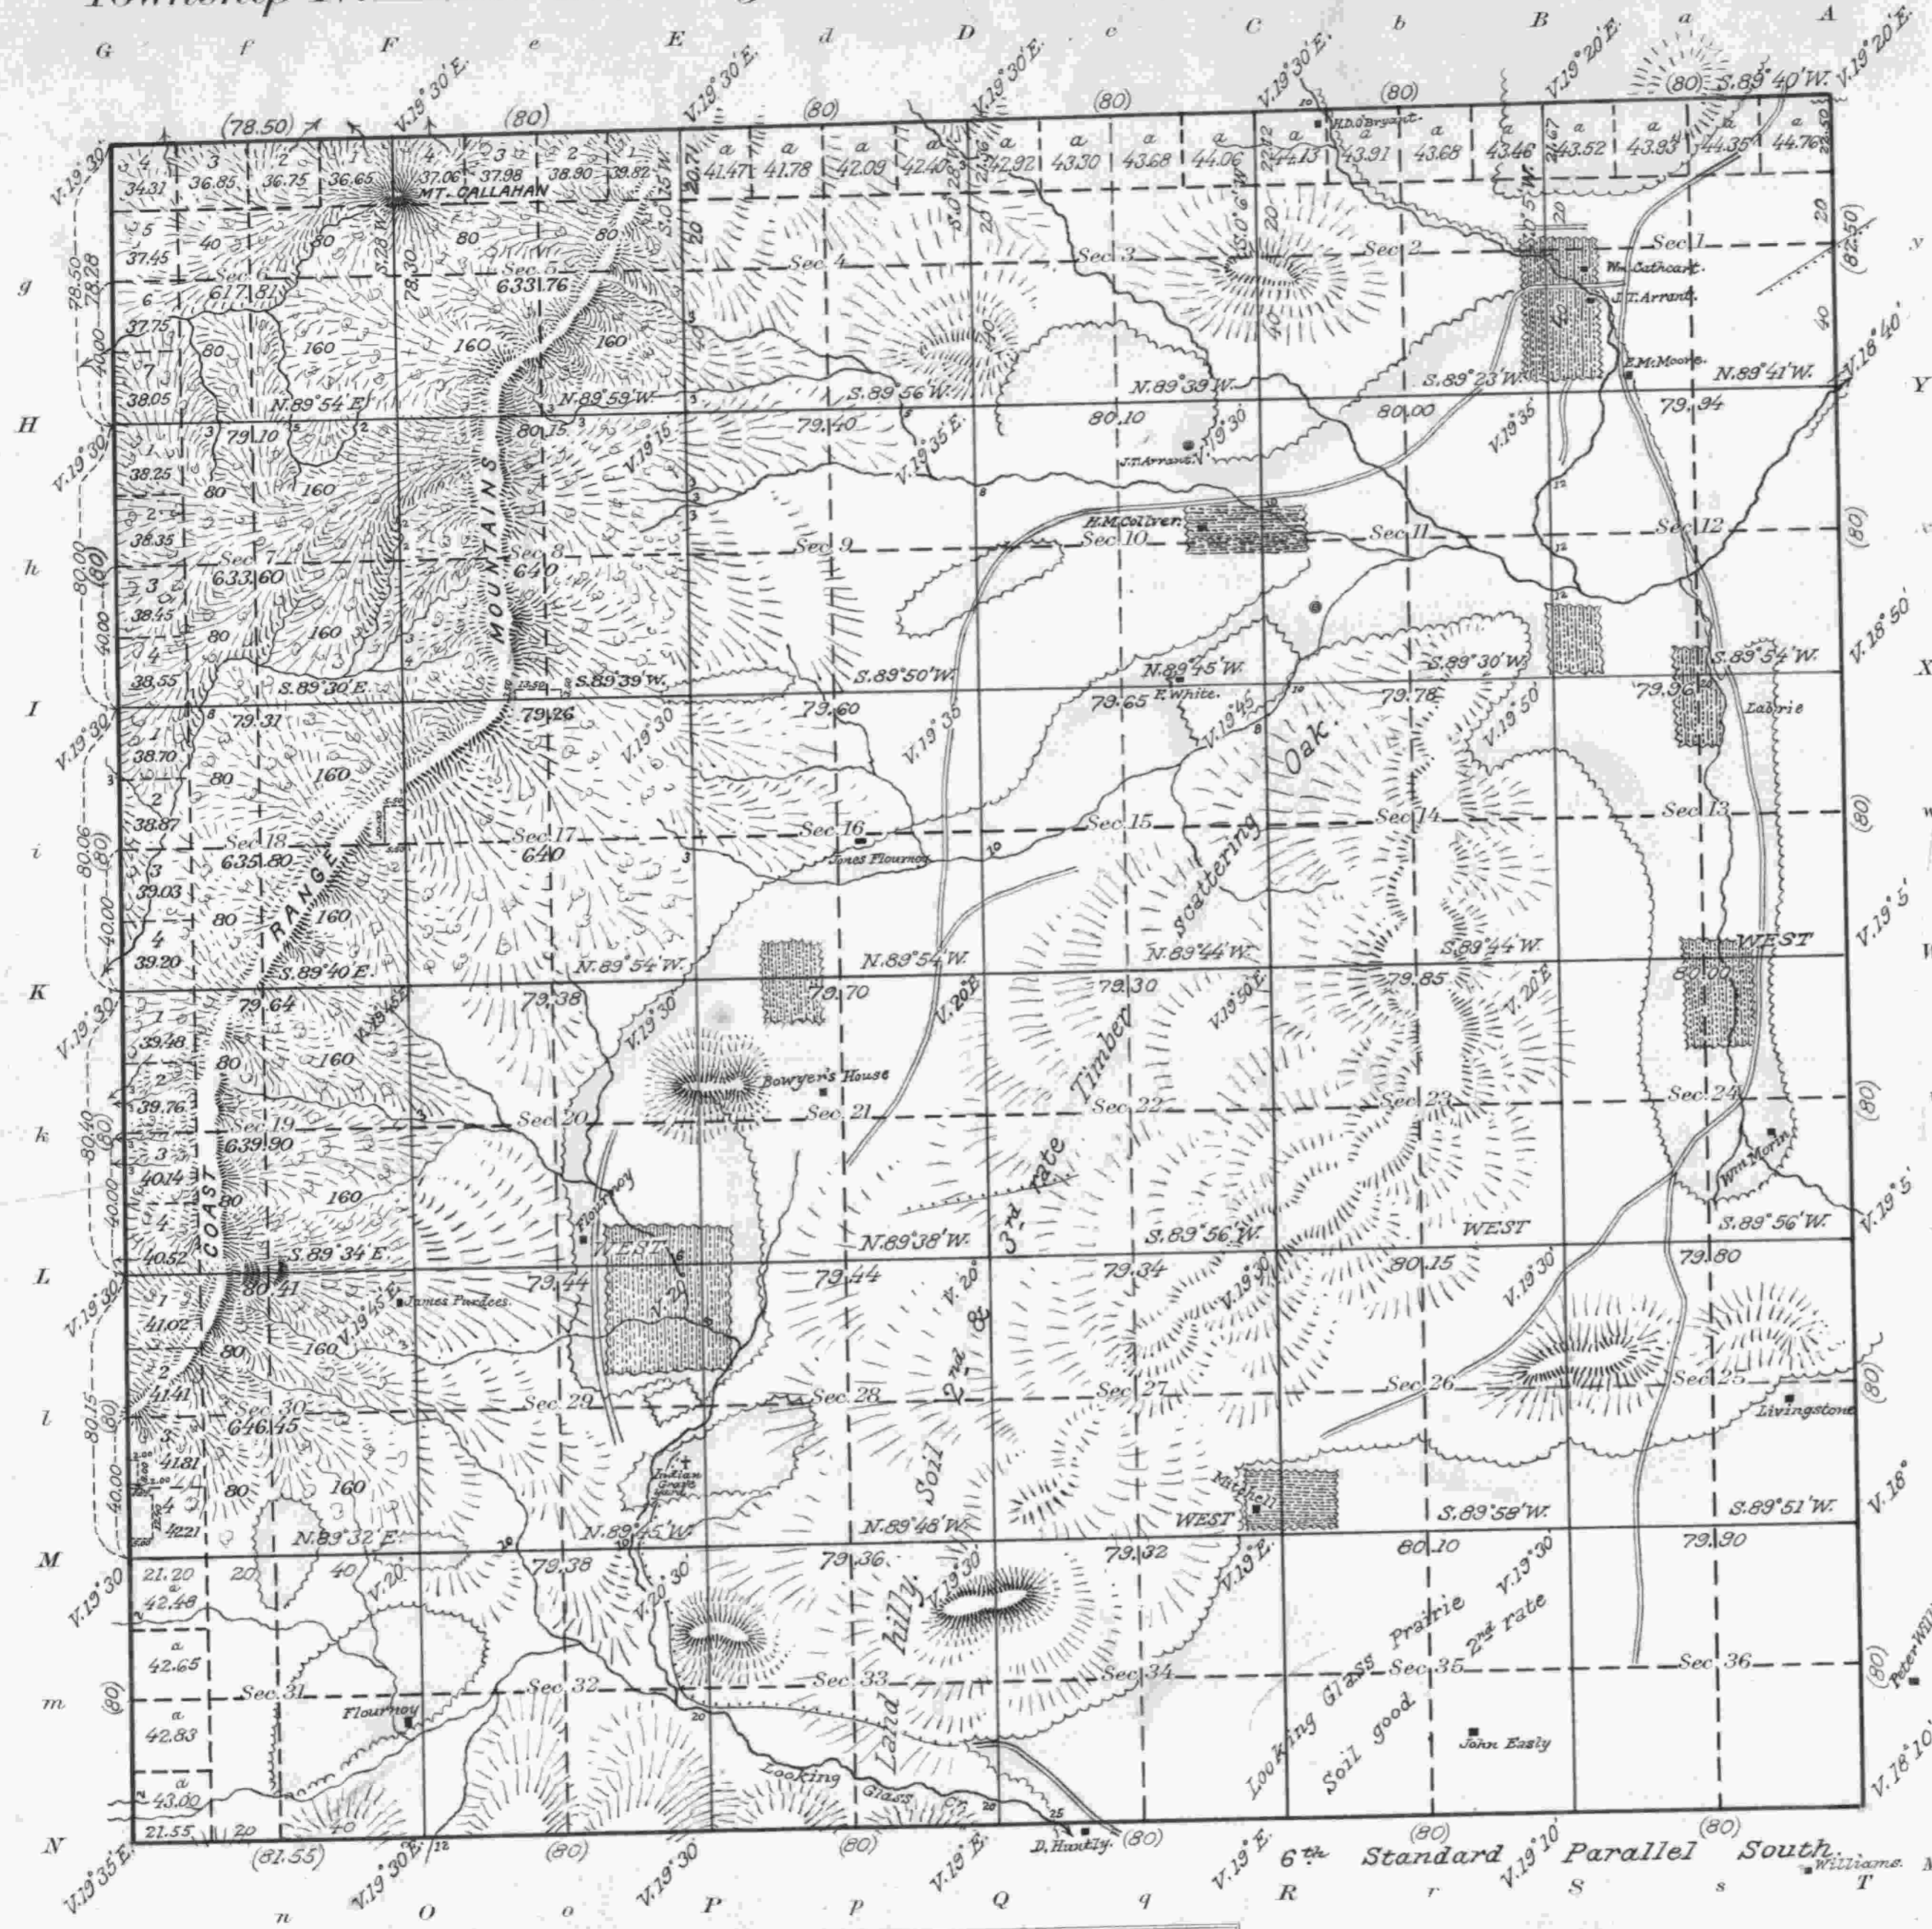

I certify this to be a correct copy of the Original Plat on file in this Office.  
 U.S. Surveyor General's Office  
 Portland, Oregon  
 Dec. 7, 1918. *Edward S. South*  
 Surveyor General of Oregon.

The annexed Map of Secs. 5, 6, 7, 8, 17, 18, 19 and 30 T. 27 S. R. 7 W. Will. Mer. Oregon, is strictly conformable to the field notes of the Survey thereof on file in this office which have been examined and approved  
 U.S. Surveyor General's Office  
 Portland, Oregon Jan. 14, 1882.  
*James H. Tolman*  
 Sur. Gen. for Oregon.

Areas in Acres	
Public Land	
Indian Reservation	
Indian Allotments	
Mineral Claims	
New Survey	5,087.32
Former "	17,984.40
<b>Total Area</b>	<b>23,071.72</b>

Scale 40 Chains to an inch  
 Mean Magnetic Declination 19° 22' 30" E.

Surveys Designated	By Whom Surveyed	No.	Contract Date	Amount of Surveys			When Surveyed	
				Mls.	chs.	ks.	Began	Completed
Township Lines	Dennis Hathorn.	57	April 12 <sup>th</sup> , 1855.	5	78	28	July 7 <sup>th</sup> , 1856.	
Subdivisions	Dennis Hathorn.	57	April 12 <sup>th</sup> , 1855.	50	79	98	Dec 5 <sup>th</sup> "	
Reclaiming Std. Parl.	"	"	" " "	6	01	55	" " "	
Total number of Acres 17984.40								
Township Lines	Dennis Hathorn.	57	April 12, 1855.					
Subdivisions	A.R. and S.C. Flint.	392	May 26, 1881.	8	76	17	July 13, 1881.	July 16, 1881.
Retracings	do do do do	do	do do do do	4	79	11		

Fractional  
 The above map of Township No. 27 South Range No. 7 West of the Willamette Meridian Territory of Oregon is strictly conformable to the field notes of the survey thereof on file in this office, which have been examined and approved  
 Surveyor General's Office.  
 Salem, December 5<sup>th</sup> 1856.  
*John S. Fieber*  
 Surveyor General of Oregon.