


TOWNSHIP N^o 28 SOUTH, RANGE N^o 3 EAST, OF THE WILLAMETTE MERIDIAN, OREGON.

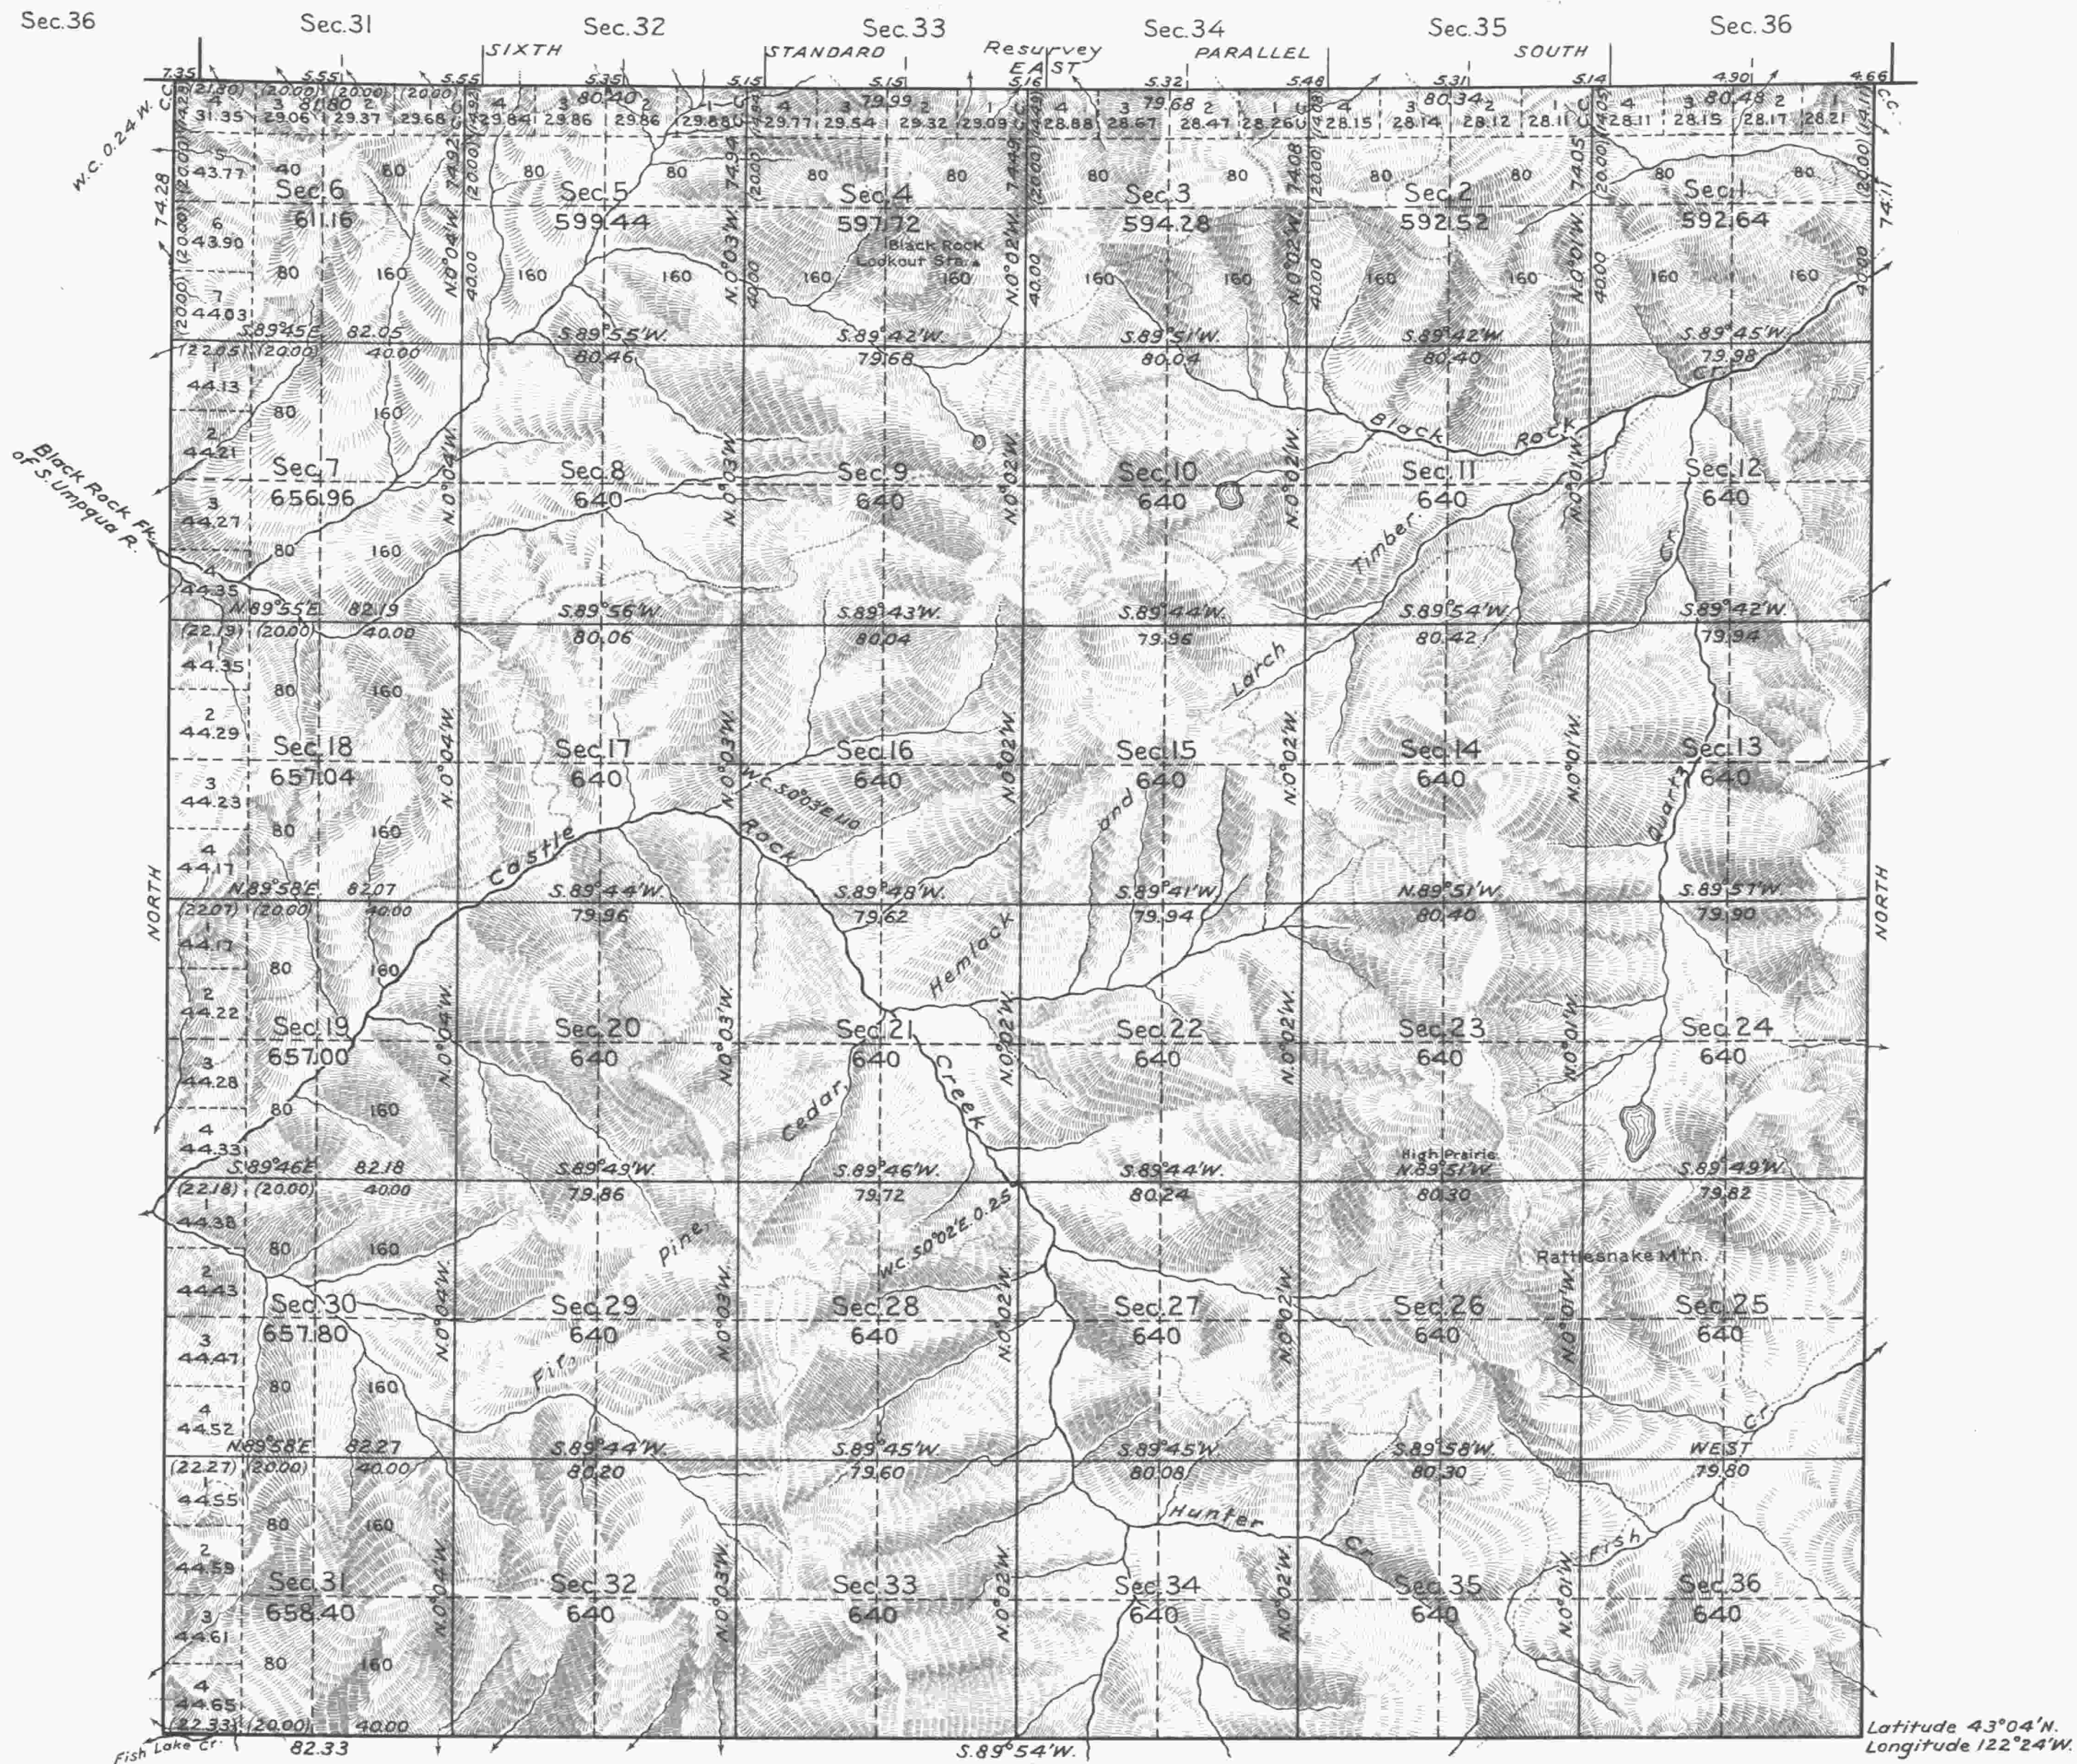

Latitude 43°04'N
Longitude 122°24'W



Mean Magnetic Declination, 20°30'E. Scale: 40 Chains to an Inch. Area Surveyed, 22,874.96 Acres.

LINES DESIGNATED	BY WHOM SURVEYED	No	GROUP DATE	MILEAGE		WHEN SURVEYED	
				MLS	CHS	BEGUN	COMPLETED
Exterior	Herbert N. Raymond	64	Dec. 27, 1920	11	74.11	Aug. 20, 1928	Aug. 15, 1929
Subdivisional				59	63.96	" 21, "	" 22, "
Meander							
Miscellaneous				31.14	" 9, 1929	" " "	

Office of U.S. Supervisor of Surveys
Denver, Colorado, July 3, 1930
The above plat of Township No. 28 South, Range No. 3 East, of the Willamette Meridian, Oregon, is strictly conformable to the field notes of the survey thereof which have been examined and approved.

William D. Dinnison
U.S. Supervisor of Surveys.

DEPARTMENT OF THE INTERIOR
GENERAL LAND OFFICE
Washington, D.C., August 6, 1930.
The survey represented by this plat having been correctly executed in accordance with the requirements of law and the regulations of this office, is hereby accepted.

Wm. C. Howell
Assistant Commissioner.