TOWNSHIP 28 SOUTH, RANGE 4 WEST, OF THE WILLAMETTE MERIDIAN, OREGON.

DEPENDENT RESURVEY, AND SUBDIVISION OF SECTION 7

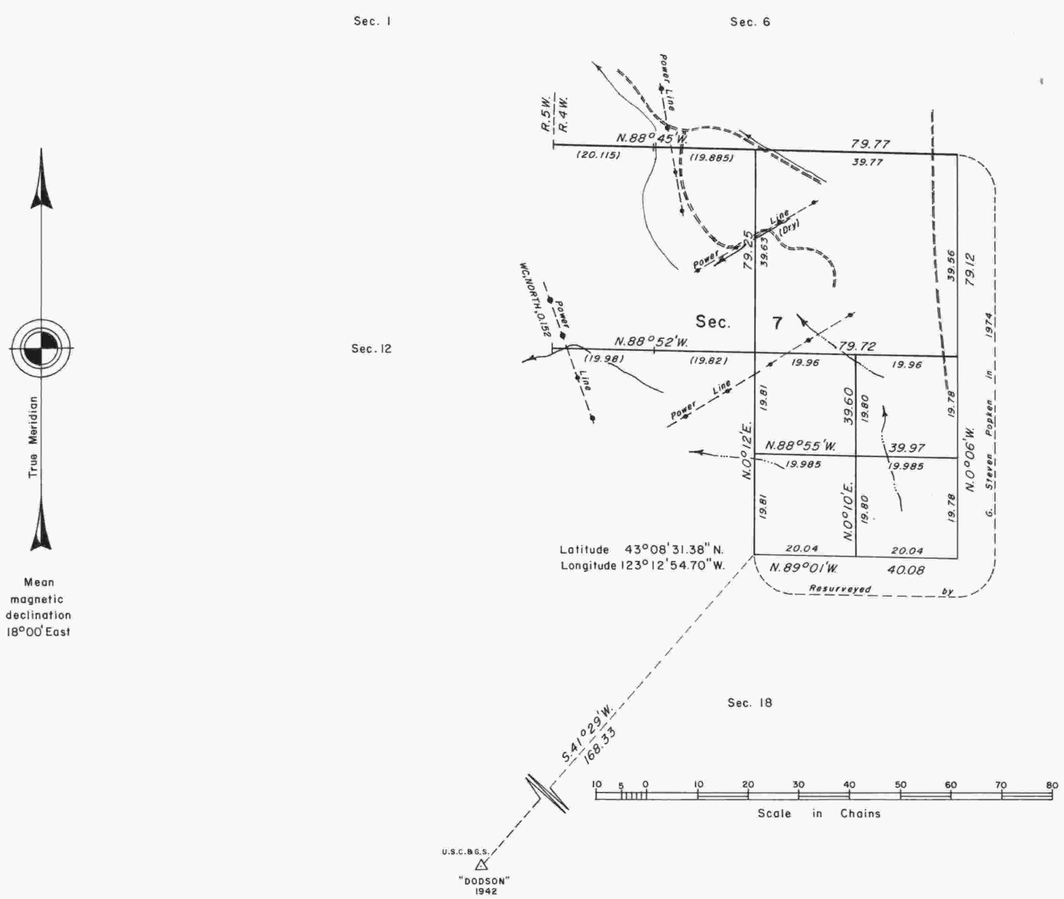

The history of surveys is contained in the field notes.

This plat represents a dependent resurvey of a portion of the subdivisional lines, T. 28 S., R. 4 W., Willamette Meridian, Oregon, designed to restore the corners in their true original locations according to the best available evidence, and the subdivision of section 7.

The lottings and areas are as shown on the plat approved August 11, 1881.

The survey was executed by Wayne L. Rogers and Lance J. Bishop, Cadastral Surveyors, beginning July 23, 1984, and completed August 6, 1984, pursuant to Special Instructions dated May 11, 1984, under Group Number 1206, Oregon.

Timber in this area consists of fir, cedar, maple, hemlock, oak, madrone, chinquapin, alder, ash, yew and cherry.

UNITED STATES DEPARTMENT OF THE INTERIOR
BUREAU OF LAND MANAGEMENT
Portland, Oregon August 22, 1986

This plat is strictly conformable to the approved field notes, and the survey, having been correctly executed in accordance with the requirements of law and the regulations of this Bureau, is hereby accepted.

For the Director

William W. Glenn
Chief Cadastral Surveyor of Oregon

rfb