Township No. 28 South Range No. 6 West of the Willamette Meridian, Oregon

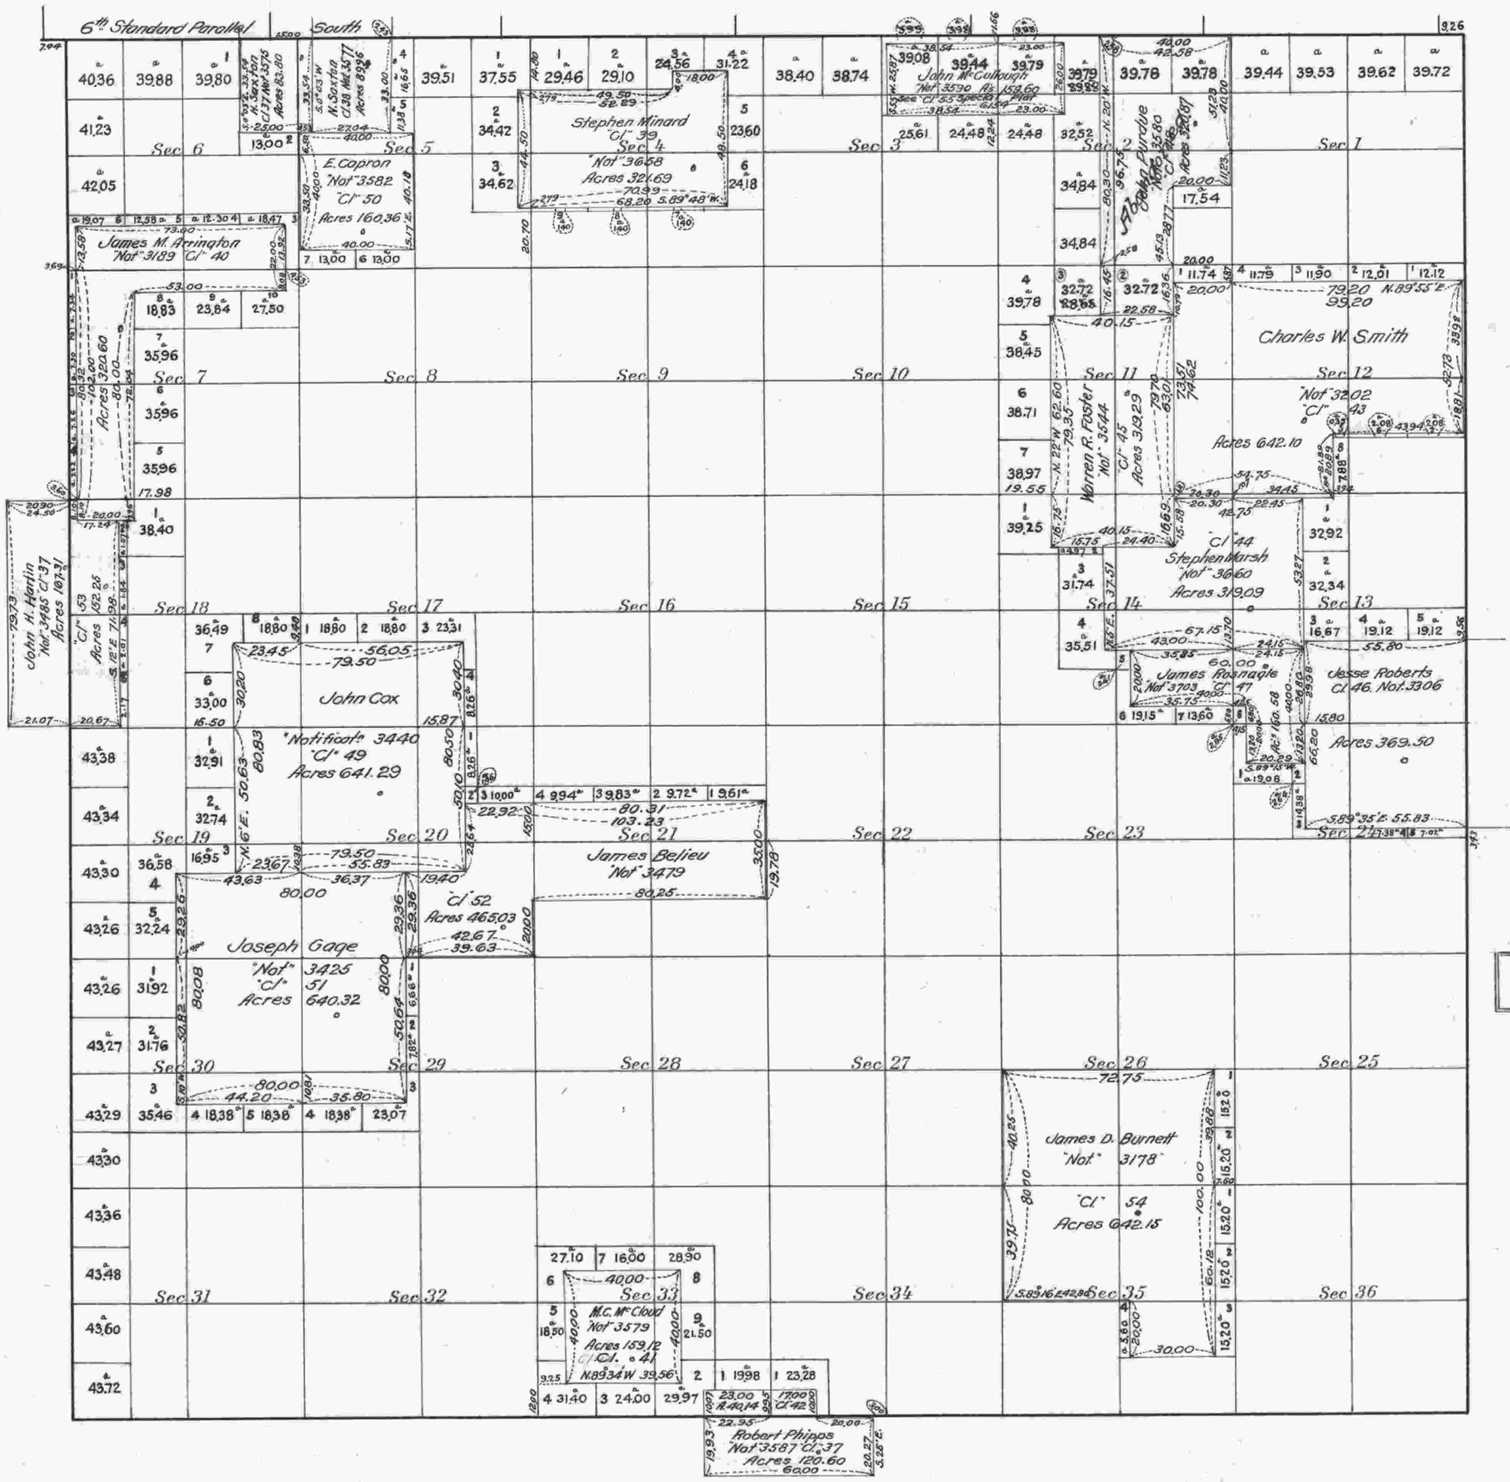

McCullough Claim No 55 said by Register to be abandoned

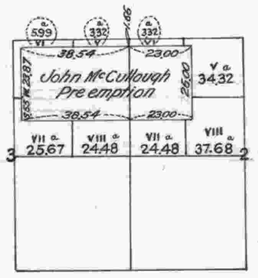

The above Special Plat showing the lottings consequent upon the re-establishment of the lines of the John McCullough donation land Sec's 2 & 3 T. 28 S. R. 6 W. Will Mer Oregon. is correct.
Surveyor General's Office
Eugene City Oregon (SIGNED) W. H. Odell,
August 20, 1872 Surveyor General.

Aggregate Area of public Lands 17068.64
do do private Surveys 6007.64

Areas in Acres	
Public Land	
Indian Reservation	
Indian Allotments	
Mineral Claims	
Water Surface	
Total Area	

TRUE MERIDIAN

0 10 20 40 80

Scale 40 Chains to an inch

Mean Magnetic Declination

Surveys Designated	By Whom Surveyed	Group No.	Group Date	Amount of Surveys Mls.	Amount of Surveys chs.	Amount of Surveys lks.	When Surveyed Begun	When Surveyed Completed

The above map of Township No. 28 South Range No. 6 West of the Willamette Meridian Oregon is strictly conformable to the field notes of the survey thereof on file in this office, which have been examined and approved

Surveyor General's Office. Ogn.
Eugene City August 1st 1860

(SIGNED) W. W. CHAPMAN
Surveyor General of Oregon

I certify this to be a correct copy of the Original plat on file in this office.
U.S. Surveyor Generals Office.
Portland Oregon June 29, 1921

Edward [illegible]
Surveyor General of Oregon

J.B.