


Township N^o 28 South, Range N^o 7 West, Willamette Meridian, Oregon.

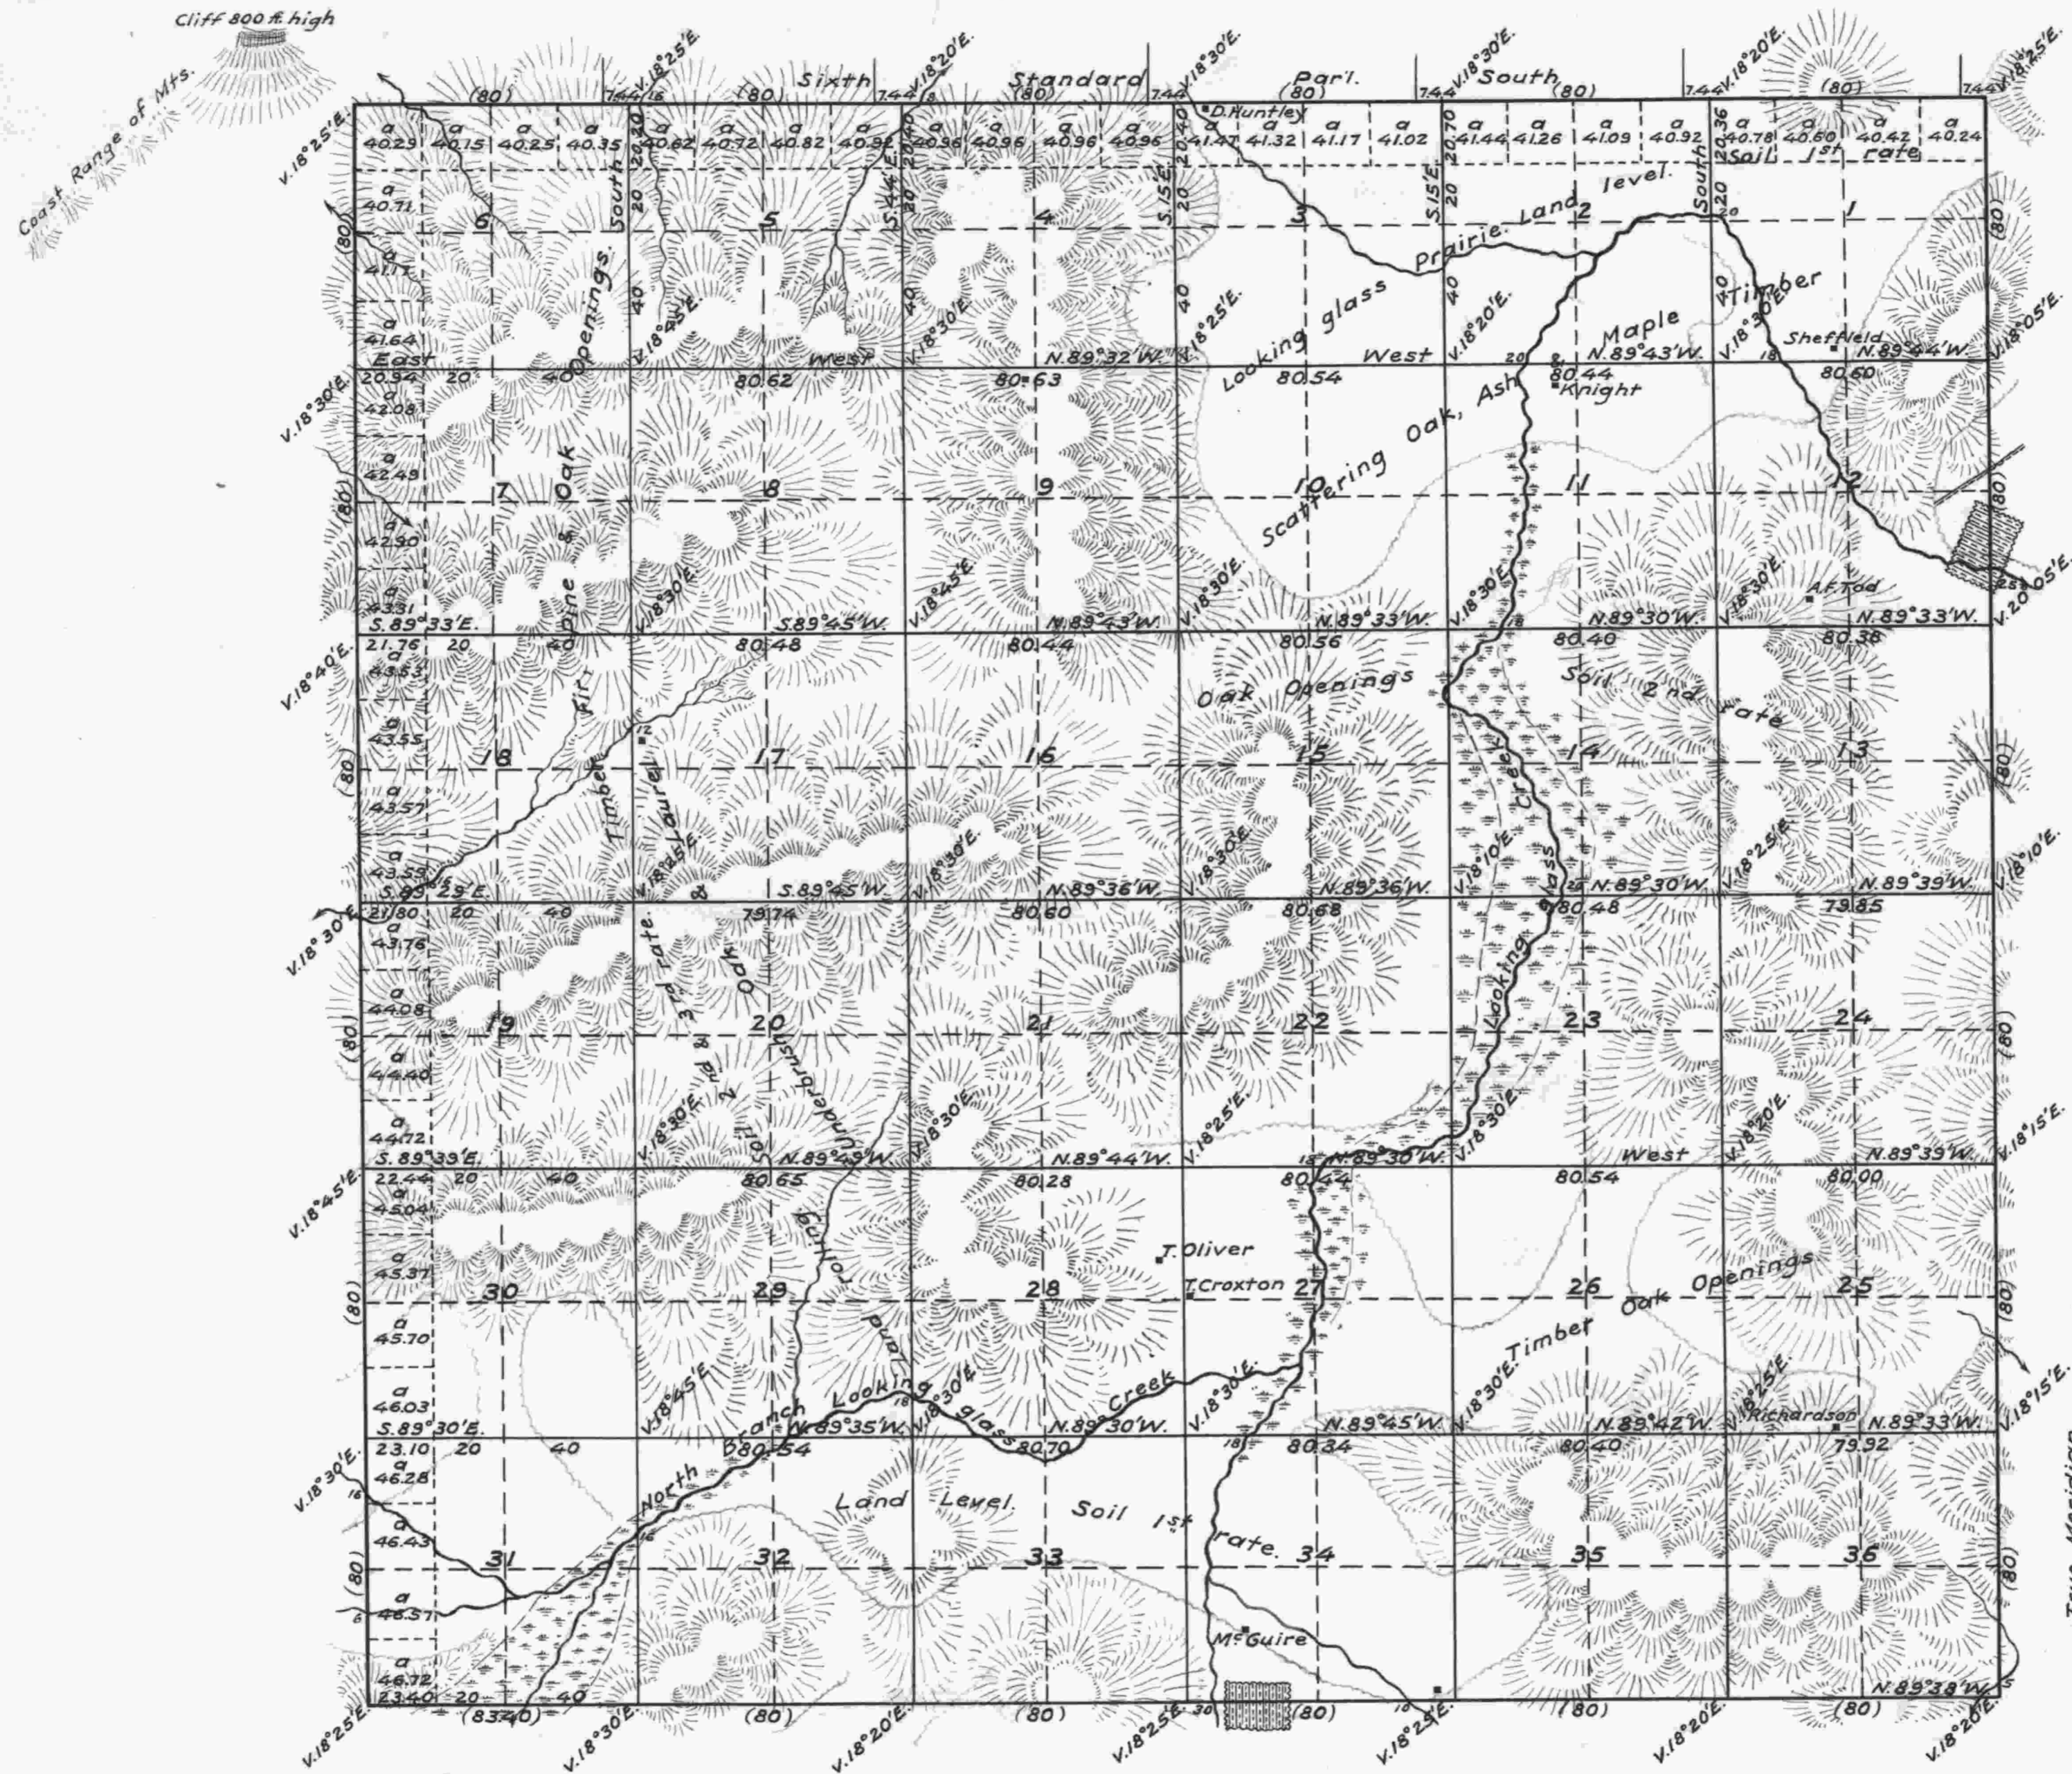

Surveys designated	By whom surveyed	Contract		Amt. of surveys			When surveyed	When charged in the Sur. Genls. Accounts
		No.	Date	Miles	chains	links		
Township Lines	Nathaniel Ford	44	May 30th, 1854	12	03	40	March 9th, 1855.	1st. Qr., 1855.
Subdivisions	Nathaniel Ford	44	May 30th, 1854	60	22	55	March 9th, 1855.	1st. Qr., 1855.
Total number of Acres		23,153.33						

The above Map of Township No. 28 South, of Range No. 7 West of the Willamette Meridian, Territory of Oregon, is strictly conformable to the field notes of the Survey thereof on file in this office which have been examined and approved.
 Surveyor General's Office,
 Salem, March 9th, 1855. (signed) C. K. Gardner.
 Surv. Gen. of Oregon.

Public Survey Office,
 Portland, Oregon,
 August 6, 1928.
 I certify the above to be a correct copy of the original plat on file in this office.
Joseph A. Lansing
 Office Cadastral Engineer.