TOWNSHIP 28 SOUTH, RANGE 7 WEST, OF THE WILLAMETTE MERIDIAN, OREGON.

DEPENDENT RESURVEY AND SUBDIVISION OF SECTION 9

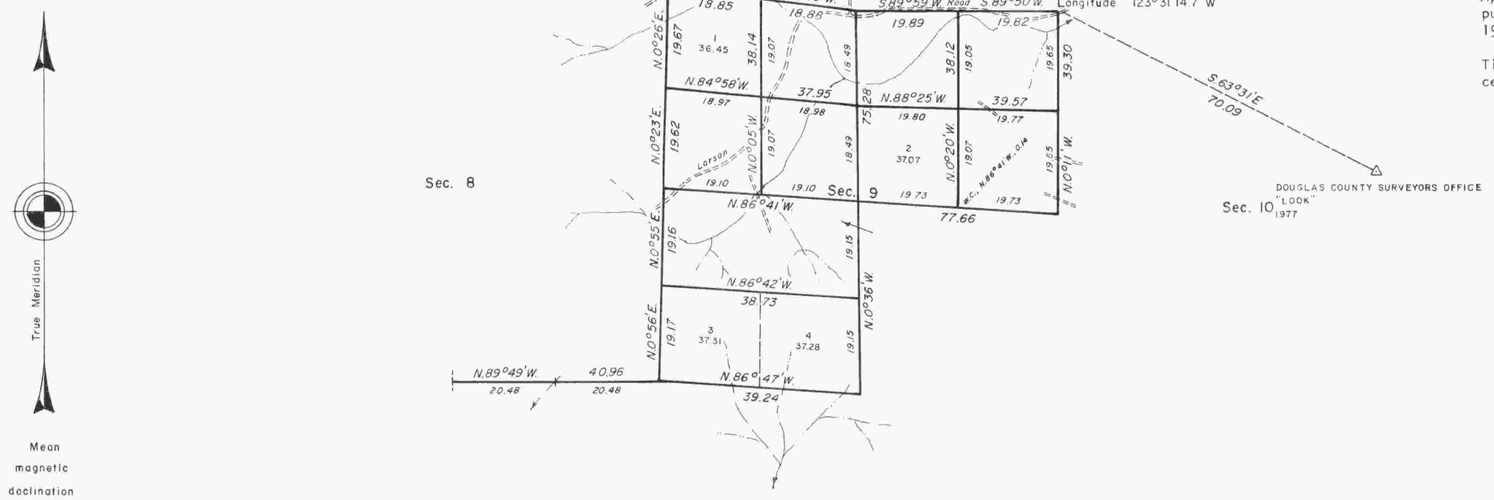

A history of surveys is contained in the field notes.

This plat represents a dependent resurvey of a portion of the subdivisional lines, T. 28 S., R. 7 W., Willamette Meridian, Oregon, designed to restore the corners in their true original locations according to the best available evidence, and the subdivision of section 9.

Except as shown hereon, the lottings and areas are as shown on the plat approved March 9, 1855.

The survey was executed by Lance J. Bishop and Wayne L. Rogers, Cadastral Surveyors, beginning April 18, 1983, and completed January 6, 1984, pursuant to Special Instructions dated October 25, 1982, under Group No. 1124, Oregon.

Timber in this area consists of fir, hemlock, cedar, oak, madrone, maple, and alder.

UNITED STATES DEPARTMENT OF THE INTERIOR
BUREAU OF LAND MANAGEMENT
Portland, Oregon February 15, 1985

This plat is strictly conformable to the approved field notes, and the survey, having been correctly executed in accordance with the requirements of law and the regulations of this Bureau, is hereby accepted.

For the Director

William W. Glenn

Chief Cadastral Surveyor of Oregon

— gee —