TOWNSHIP 28 SOUTH, RANGE 7 WEST, OF THE WILLAMETTE MERIDIAN, OREGON

DEPENDENT RESURVEY AND SUBDIVISION OF SECTIONS

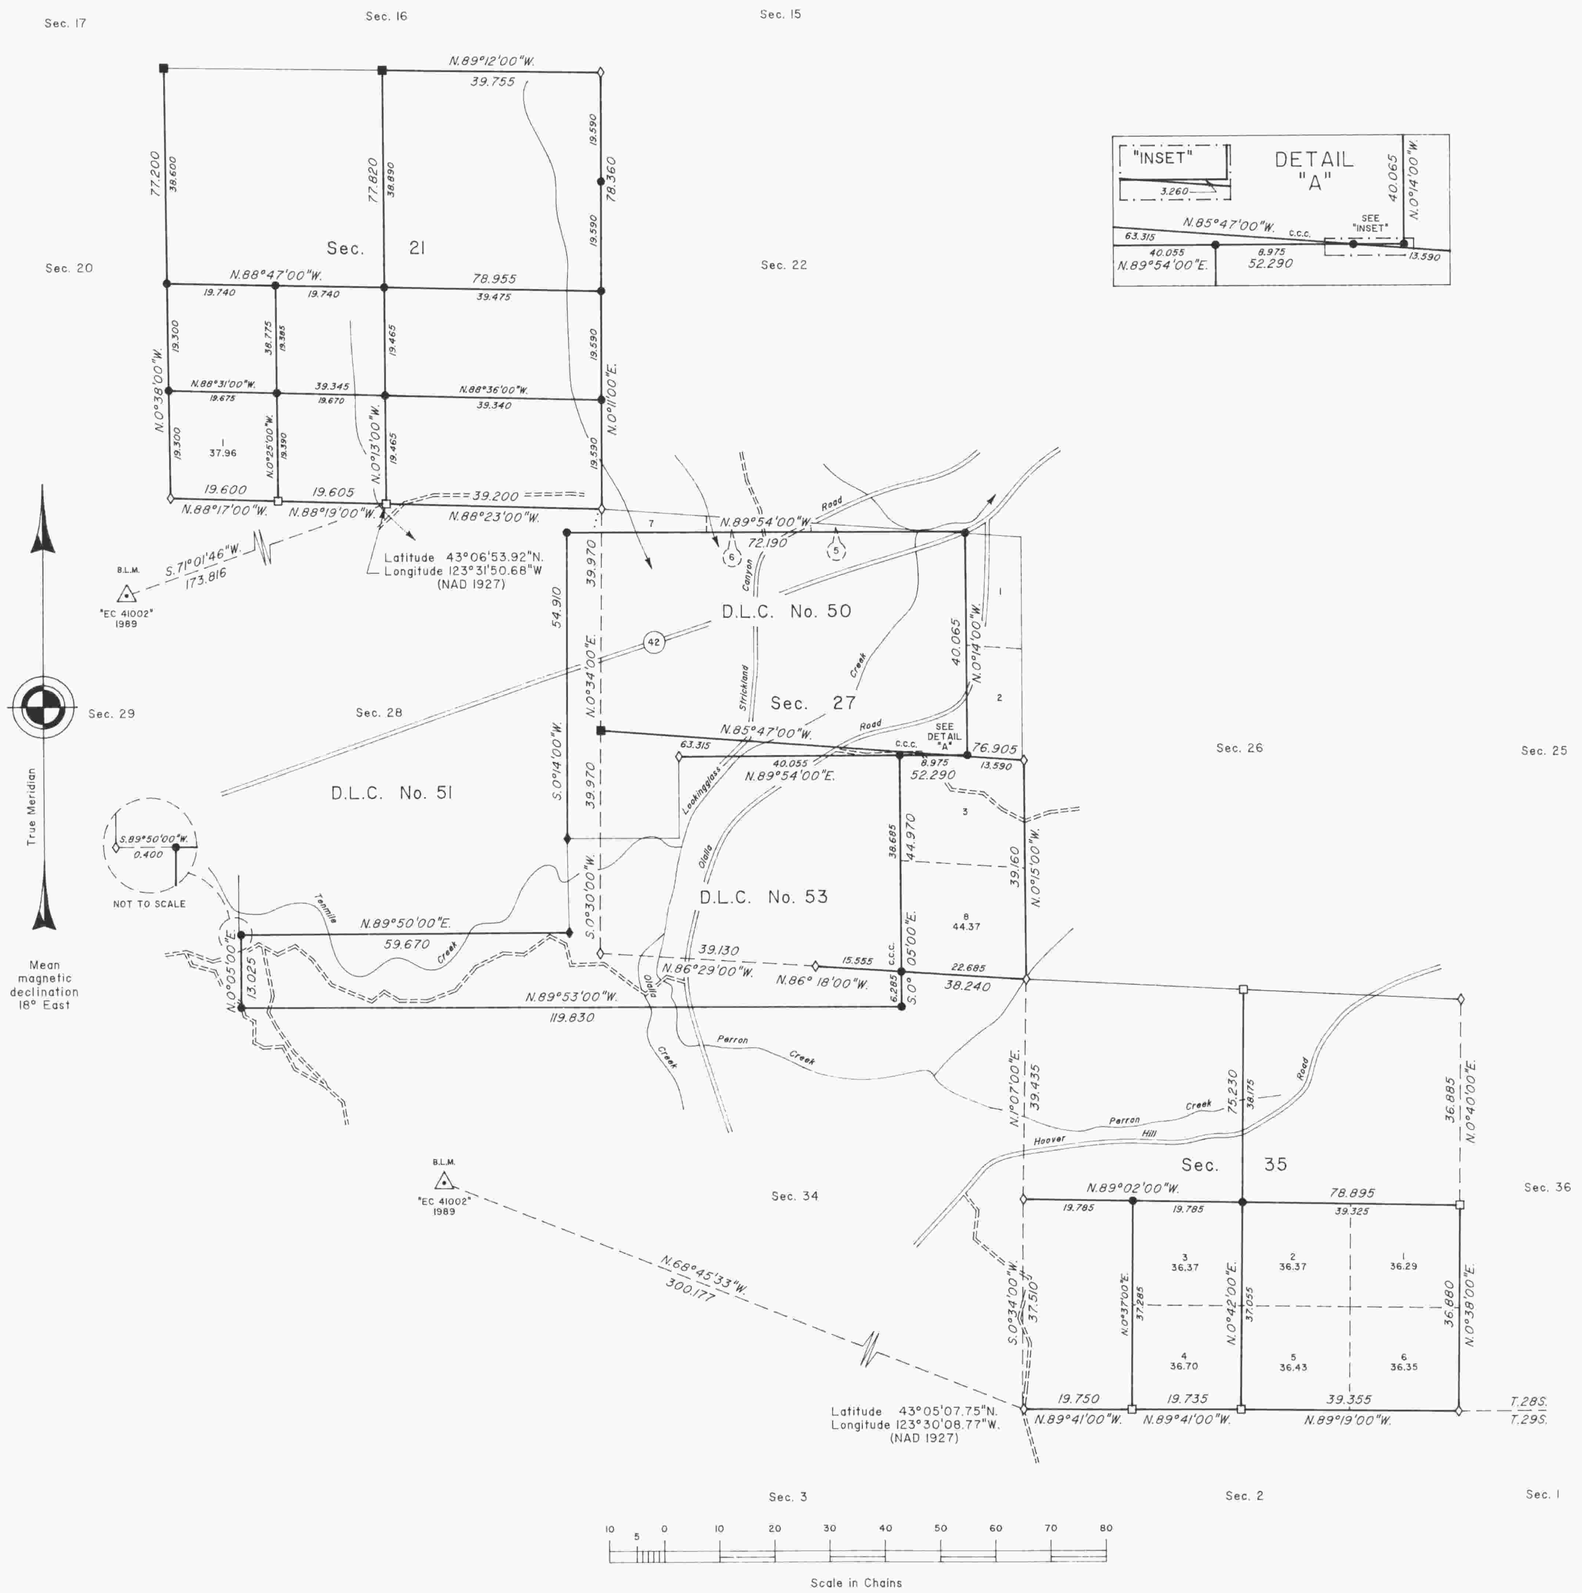

A history of surveys is contained in the field notes.

This plat represents a dependent resurvey of portions of the south, west and north boundaries, subdivisional lines, and boundaries of Donation Land Claim Nos. 50 and 53, T. 28 S., R. 7 W., Willamette Meridian, Oregon, designed to restore the corners in their true original locations according to the best available evidence, and the subdivision of sections 7, 18, 21, 27 and 35.

Except as shown hereon, the lottings and areas are as shown on the plats approved March 9, 1855, March 30, 1863, and February 15, 1926.

The survey was executed by Bryan S. Seibold and Robert J. Chappel, Cadastral Surveyors, beginning May 1, 1991, and completed May 26, 1994, pursuant to Special Instructions dated March 12, 1991, Supplemental Special Instructions dated July 9, 1991, Second Supplemental Special Instructions dated August 7, 1991, and Third Supplemental Special Instructions dated May 28, 1992, under Group Number 1585, Oregon.

Timber in this area consists of fir, cedar, hemlock, alder, maple, oak, chinquapin, pine, ash, yew and madrone.

The ties to the geodetic control station are reported as mean bearing and sea level distance.

LEGEND

- ◇ Original corner previously remonumented
- ◆ Original corner remonumented this survey
- □ Corner previously established or reestablished
- ■ Corner previously established or reestablished, and remonumented this survey
- ● Corner established or reestablished this survey

UNITED STATES DEPARTMENT OF THE INTERIOR
BUREAU OF LAND MANAGEMENT

Portland, Oregon — November 12, 1997

This plat is strictly conformable to the approved field notes, and the survey, having been correctly executed in accordance with the requirements of law and the regulations of this Bureau, is hereby accepted.

For the Director

Wayne M. Gardner

Chief Cadastral Surveyor of Oregon

B.S.S.