Township No. 28 South, Range No. 8 West, Willamette Meridian, Oregon.

The above Map of the Subdivisional lines between the following sections, to wit: 4 and 5, 7 and 8, 5 and 8, 6 and 7, and 5 and 6 of Township 28 South, Range 8 West, Will. Mer., Or., is strictly conformable to the original field notes of the survey thereof on file in this Office, which have been examined and approved.
U. S. Surv. Gen'l's. Office,
Portland, Oregon,
January 10th, 1876.

Surv. Gen'l. of Or.

General Description

The portion of this Township included in the foregoing survey is on or near the summit of the "Coast Range" Mountains. Very little of it is at all valuable except for timber, mostly fir which covers the hillsides. The aspect of the country is broken and precipitous, and only a great demand for timber will render it valuable.

The above Map of the subdivisional lines of T. 28 S., R. 8 W., Will. Mer., Oregon, is strictly conformable to the original field notes of the survey thereof on file in this Office which have been examined and approved.
U. S. Surveyor General's Office,
Portland, Oregon, Dec. 17th, 1875.
(signed)
Ben Simpson.
Sur. Gen'l. of Or.

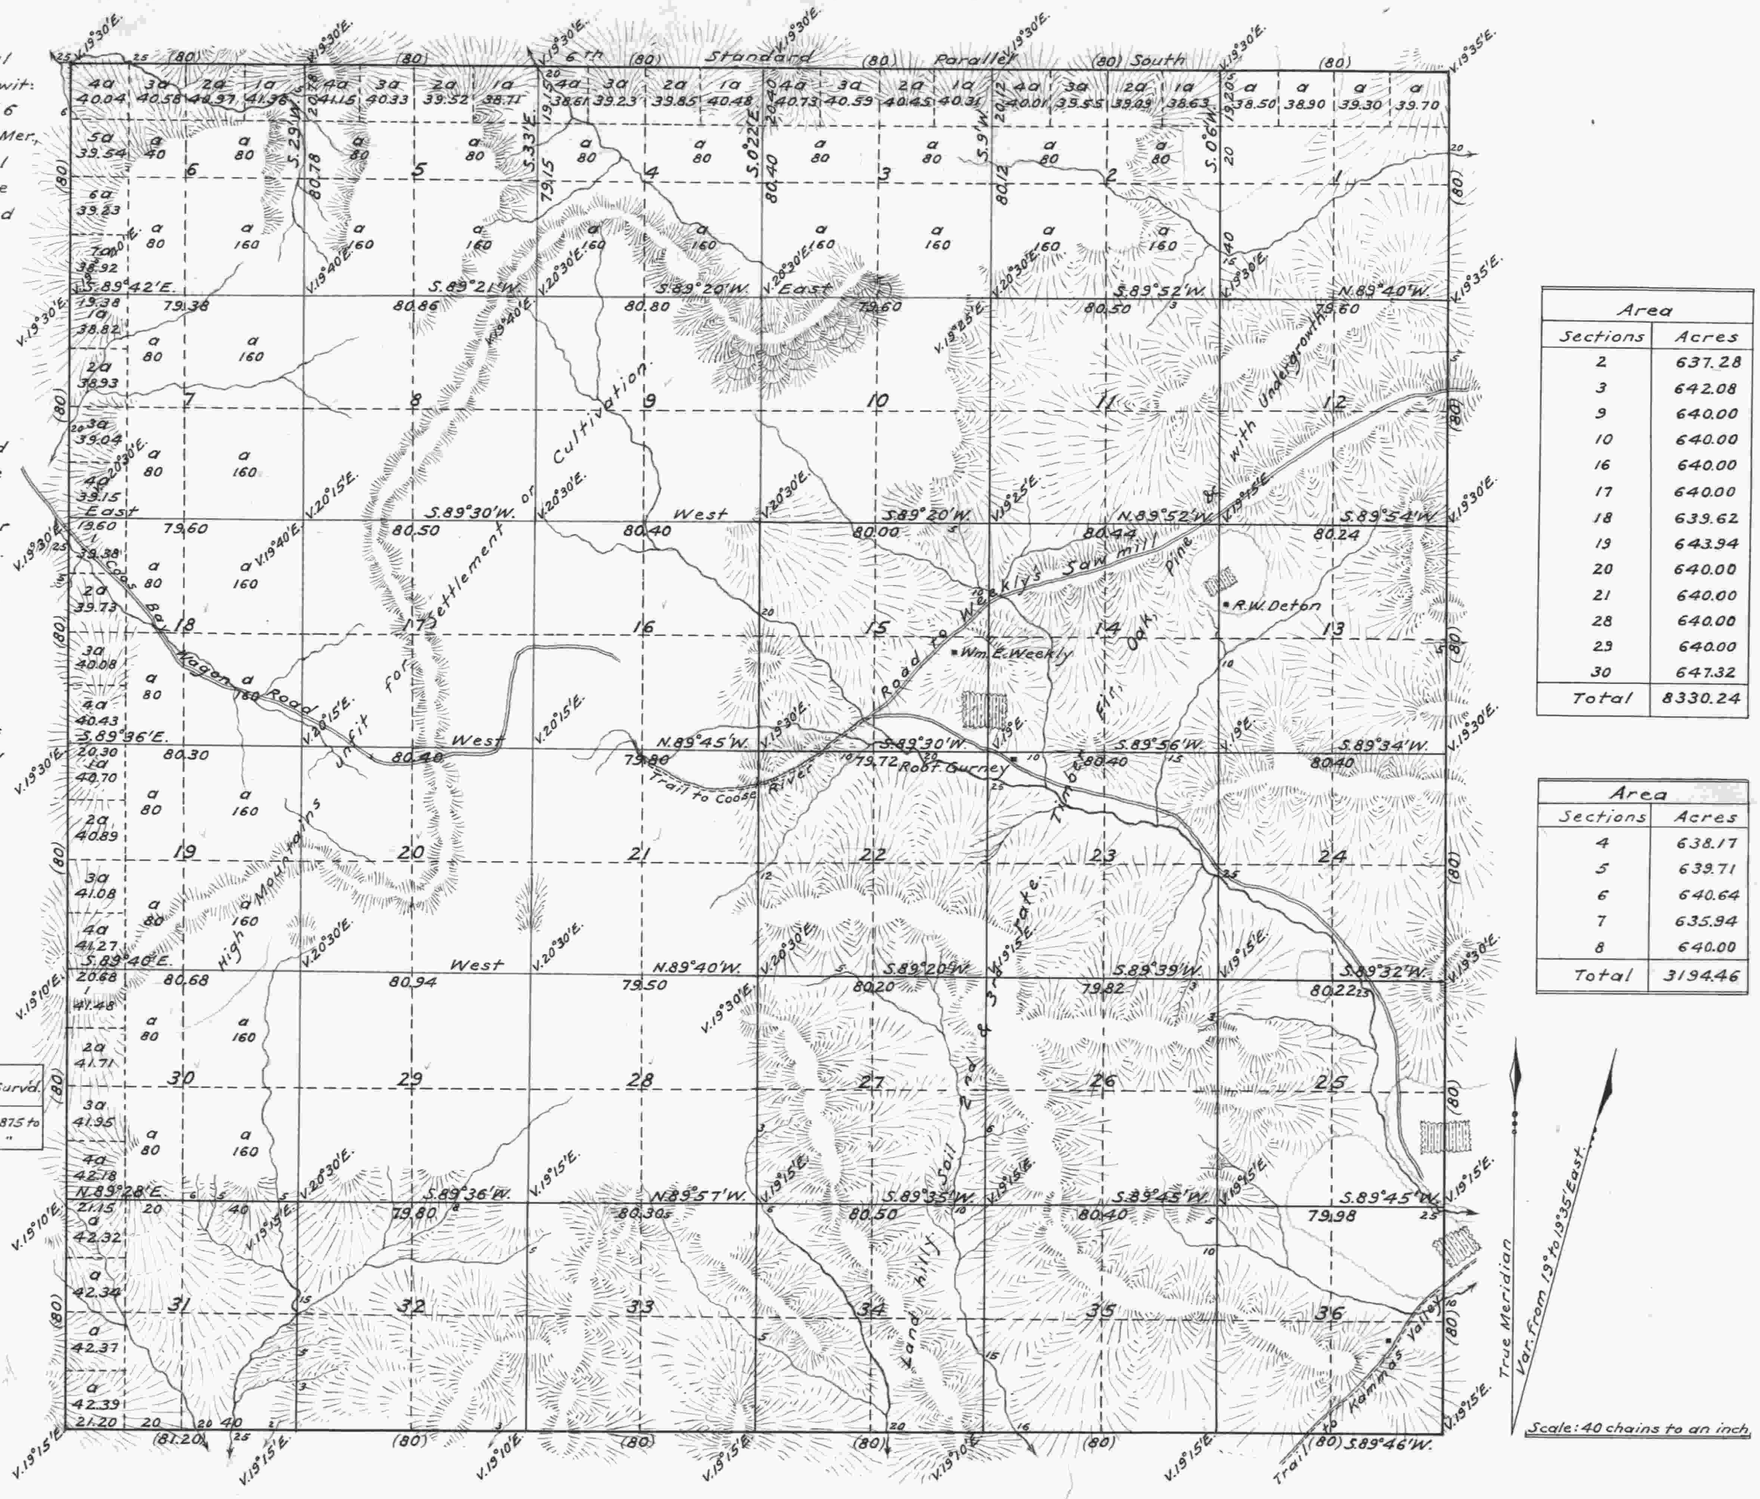

Area	
Sections	Acres
2	637.28
3	642.08
9	640.00
10	640.00
16	640.00
17	640.00
18	639.62
19	643.94
20	640.00
21	640.00
28	640.00
29	640.00
30	647.32
Total	8330.24

Area	
Sections	Acres
4	638.17
5	639.71
6	640.64
7	635.94
8	640.00
Total	3194.46

Lines	Contractor	Contract No.	Contract Date	Amt. Surv'd Mls.	Chs.	Lks.	When Surv'd.
Subdivs.	Geo. S. Pershin	238	July 13, 1875	5	00	17	Oct. 16, 1875 to " 17, "

Surveys designated	By whom surveyed	Contract No.	Contract Date	Amt. of surveys Miles	chains	links	When surveyed
Township Lines	Dennis Hathorn	57	April 12th, 1855	12	01	20	July 7th, 1856
Subdivisions	Dennis Hathorn	57	April 12th, 1855	34	02	87	July 7th, 1856
Total number of Acres 11,525.82							
Subdivisions	W. S. Chapman	234	June 24th, 1875	21	03	04	Comm. July 24, 1875 Comp. August 5, 1875
Blue lines indicate new surveys							

The above Map of Fractional Township No. 28 South, of Range No. 8 West, Willamette Meridian, Territory of Oregon, is strictly conformable to the field notes of the survey thereof on file in this office which have been examined and approved.
Surveyor General's Office,
Salem, July 7th, 1856.
(signed)
John S. Zieber.
Sur. Gen. of Oregon.

Public Survey Office,
Portland, Oregon,
September 9, 1935.
I certify this to be a correct copy of the original plat on file in this office.
Joseph A. Young
Office Cadastral Engineer.

B.L.R. Copy.