Township No. 28 South Range No. 8 West Willamette Mer

1123

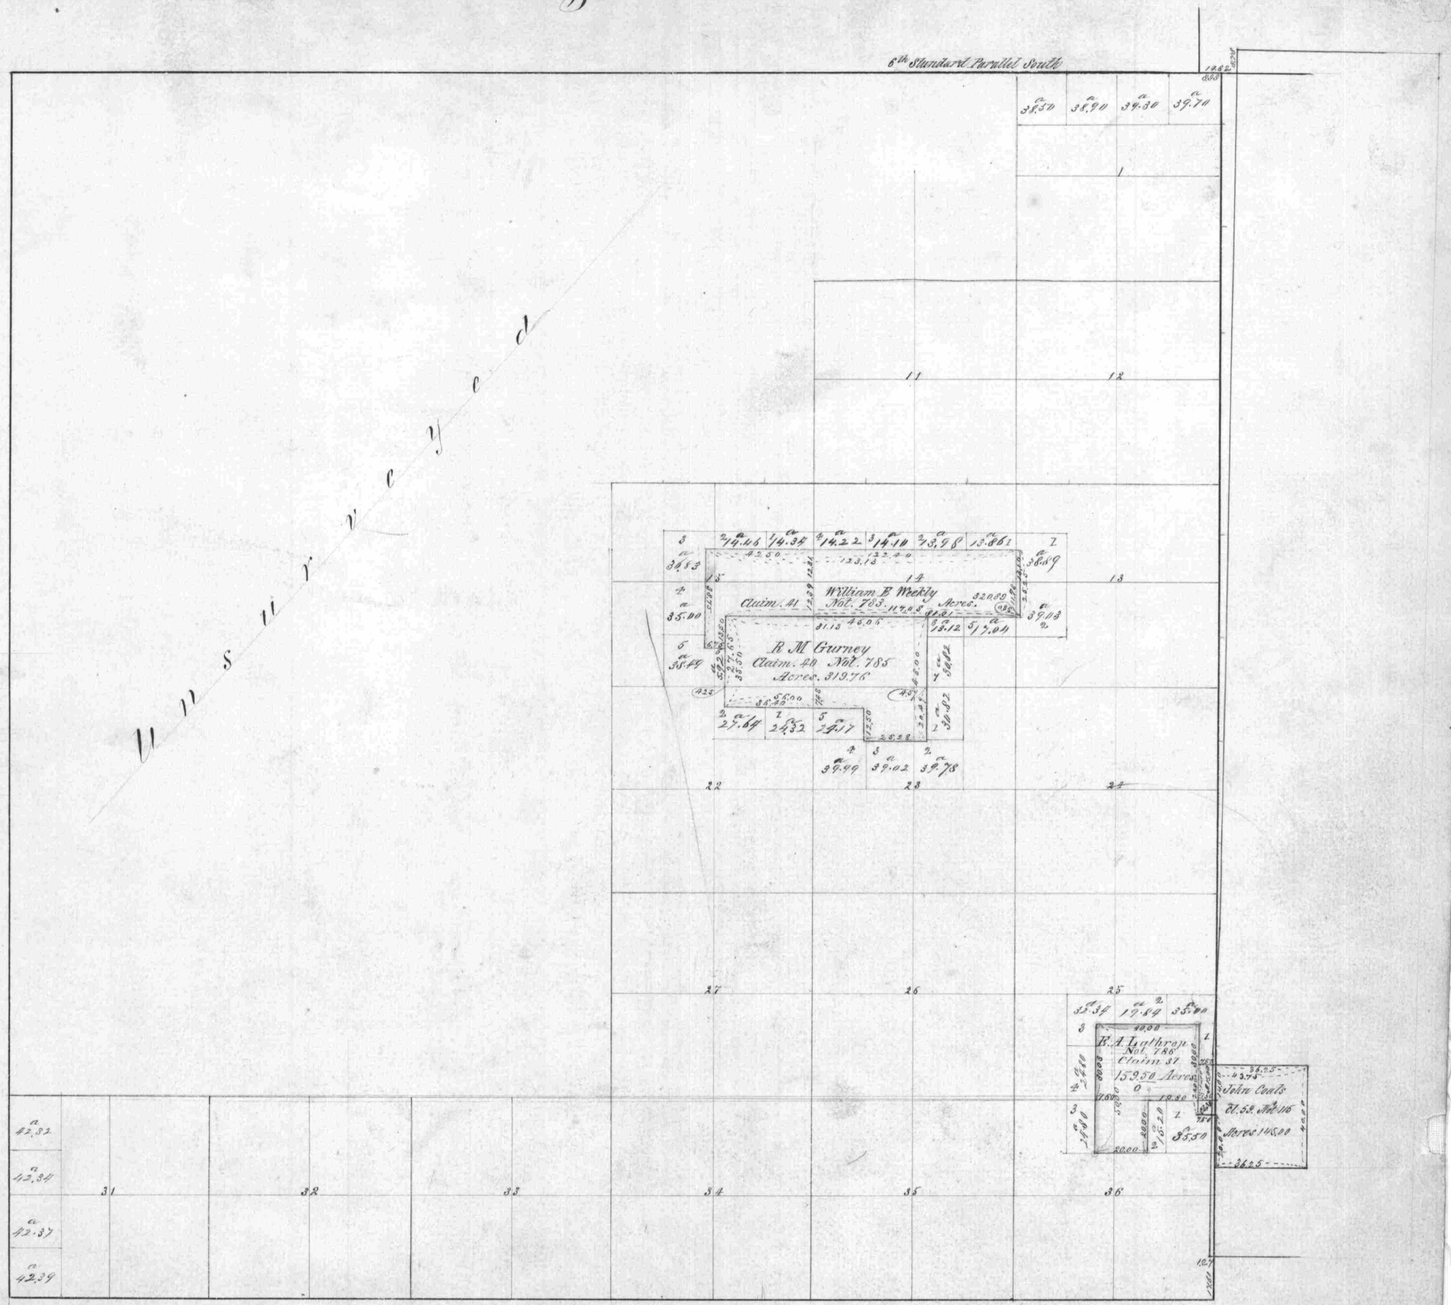

Sheet 6

Aggregate Area of Public lands	10719.14
" " Private Surveys	815.15
Deduct error in computation	8.47
Total return on Township plat	11525.82

11534 29

The above Map of the survey of claims in Township No. 28 South Range No. 8 West Willamette Meridian, Oregon, is strictly conformable to the field notes of the surveys thereof on file in this Office, which have been examined and approved.

Surveyor Generals Office,
Eugene City, January 16th 1862

J. P. Boyd
Surv. Gen. of Oregon.