Township No. 28 South, Ranges Nos. 7, 7½ & 8 West of the Willamette Meridian, Oregon.

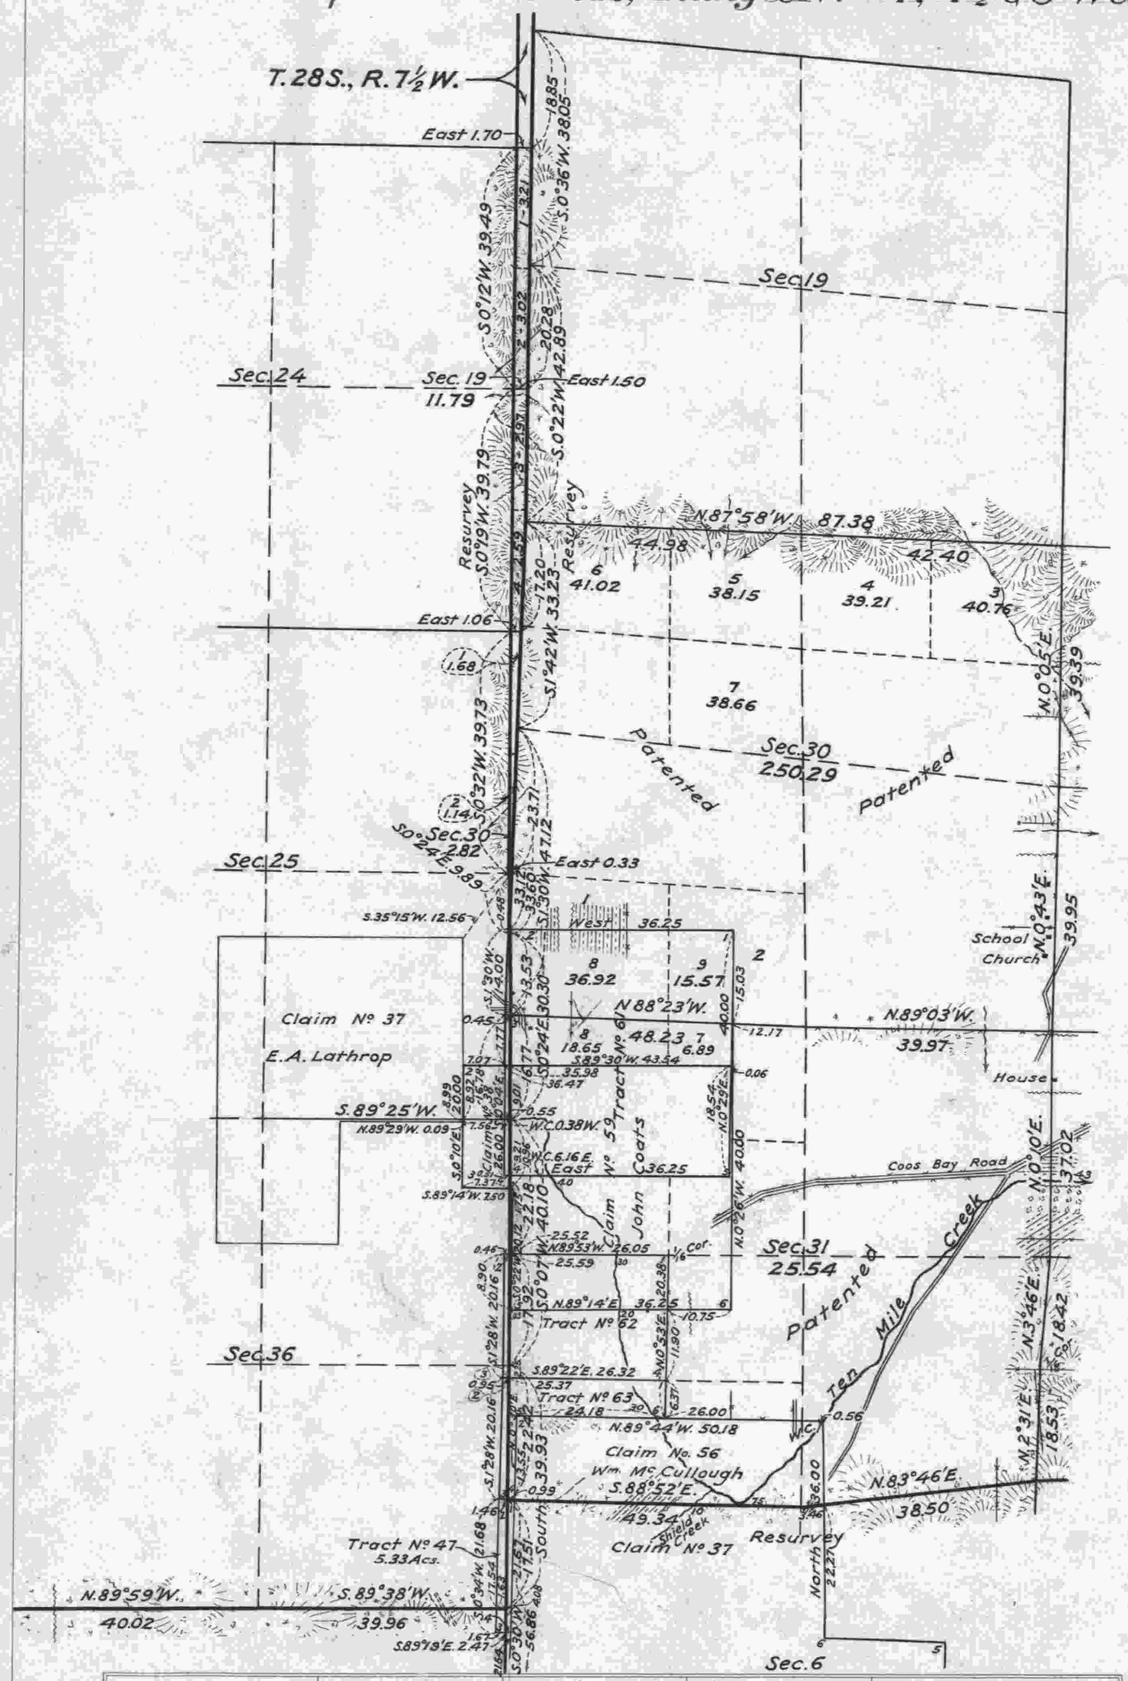

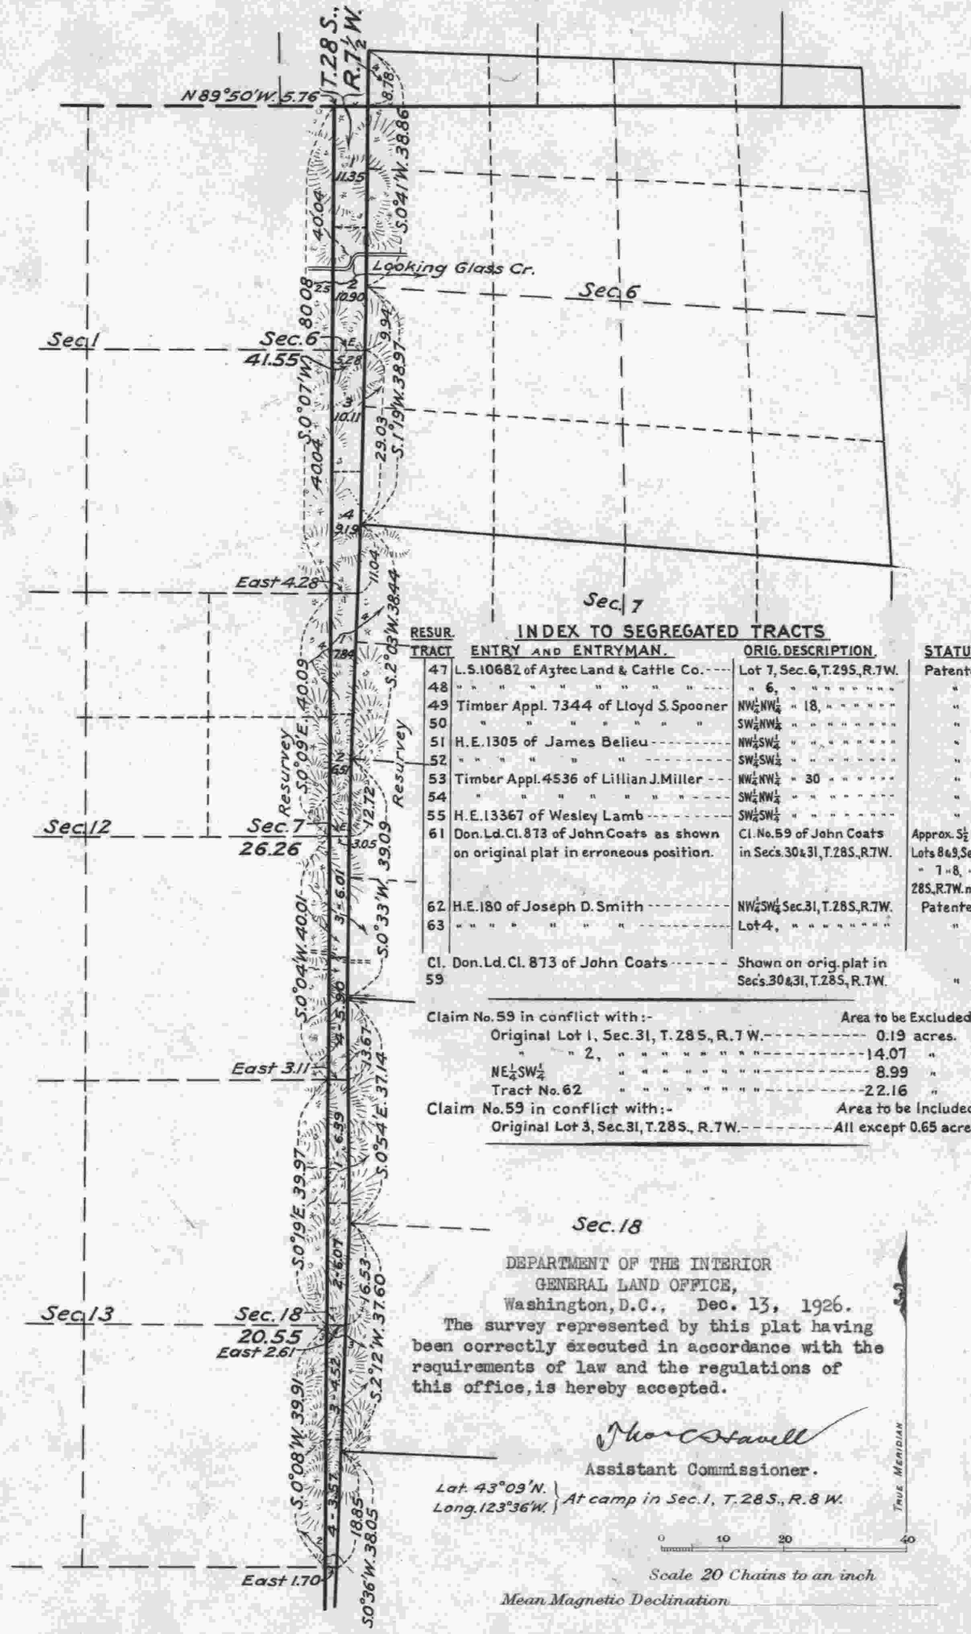

INDEX TO SEGREGATED TRACTS

RESUR. TRACT	ENTRY AND ENTRYMAN.	ORIG. DESCRIPTION.	STATUS.
47	L.S.10682 of Aztec Land & Cattle Co.	Lot 7, Sec. 6, T. 29 S., R. 7 W.	Patented
48	" " " " " " "	" 6, " " " " " "	"
49	Timber Appl. 7344 of Lloyd S. Spooner	NW¼NW¼ " 18, " " " "	"
50	" " " " " "	SW¼NW¼ " " " " " "	"
51	H.E. 1305 of James Belieu	NW¼SW¼ " " " " " "	"
52	" " " " " "	SW¼SW¼ " " " " " "	"
53	Timber Appl. 4536 of Lillian J. Miller	NW¼NW¼ " 30 " " " "	"
54	" " " " " "	SW¼NW¼ " " " " " "	"
55	H.E. 13367 of Wesley Lamb	SW¼SW¼ " " " " " "	"
61	Don. Ld. Cl. 873 of John Coats as shown on original plat in erroneous position.	Cl. No. 59 of John Coats in Sec's. 30 & 31, T. 28 S., R. 7 W.	Approx. S½ Pat'd. Lots 8 & 9, Sec. 30 & " 7 & 8, " 31, T. 28 S., R. 7 W. not Pat.
62	H.E. 180 of Joseph D. Smith	NW¼SW¼ Sec. 31, T. 28 S., R. 7 W.	Patented
63	" " " " " "	Lot 4, " " " " " "	"
Cl. Don. Ld. Cl. 873 of John Coats 59		Shown on orig. plat in Sec's. 30 & 31, T. 28 S., R. 7 W.	"

Claim No. 59 in conflict with:- — Area to be Excluded.
Original Lot 1, Sec. 31, T. 28 S., R. 7 W. — 0.19 acres.
" " 2, " " " " " " " — 14.07 "
NE¼SW¼ " " " " " " " " — 8.99 "
Tract No. 62 " " " " " " " " — 22.16 "
Claim No. 59 in conflict with:- — Area to be Included.
Original Lot 3, Sec. 31, T. 28 S., R. 7 W. — All except 0.65 acres.

DEPARTMENT OF THE INTERIOR
GENERAL LAND OFFICE,
Washington, D.C., Dec. 13, 1926.

The survey represented by this plat having been correctly executed in accordance with the requirements of law and the regulations of this office, is hereby accepted.

Thos. C. Havell
Assistant Commissioner.

Lat. 43°09'N. } At camp in Sec. 1, T. 28 S., R. 8 W.
Long. 123°36'W. }

0 10 20 40

Scale 20 Chains to an inch

Mean Magnetic Declination

Surveys Designated	By Whom Surveyed	Group No.	Group Date	Amount of Surveys Mls.	chs.	lks.	When Surveyed Begun	Completed
Exteriors	Fred Mensch U.S.C.E.	109	Feb. 25, 1924	13	04	26		
Subdivisions	" " "	"	" " "	4	19	04	May 6, 1924	Sept. 19, 1924
Miscellaneous	" " "	"	" " "	10	69	19		

The above map of Township No. 28 South, Ranges Nos. 7, 7½ & 8 West of the Willamette Meridian, Oregon, is strictly conformable to the field notes of the survey thereof which have been examined and approved.

Office of U.S. Supervisor of Surveys,
Denver Colorado, Feb. 15, 1926.

Clinton Johnson
U. S. Supervisor of Surveys.

B.L.F.

690