103 Township No 29 South Range No 1 West of the Willamette Meridian Oregon.

2

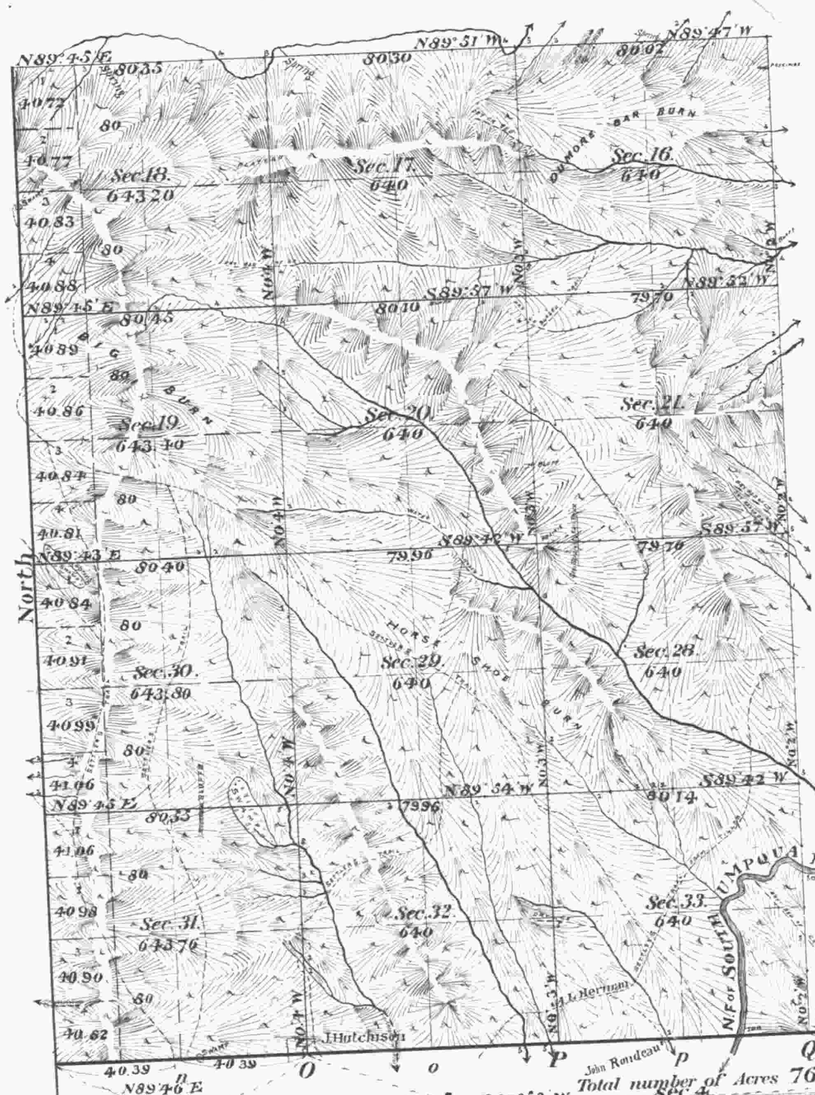

Surveys Designated	By Whom Surveyed	Date of Contract	Amount of Surveys M.	Ch^s	Lk^s	When Surveyed	No of Contract
Township lines	Fred Mensch	Sept 14 1904	4	00	00	Aug 7 to 17 1905	757
Subdivisions	"	" " "	24	01	63	Aug 17 1905 to Nov 13 1907	"
Retracement of S Bdy of Sec 31	"	" " "	1	00	78	"	"
N and W Bdries of Tp	Homer D. Angell	May 5 1902				1902	746
Original Survey of S Bdy of Sec 31 35 and 36	Dennis Hathorn	June 8 1857				1857	73

The above Map of Township No 29 South, Range No 1 West of the Willamette Meridian Oregon, has been amended, and is strictly conformable to the field notes of the corrections thereof which have been examined, approved, and filed in this Office, done by order of Hon Commissioner's Letter "E" dated April 30 1907

Surveyor-Generals Office
Portland, Oregon Nov 25 1908 } Geo A Nesgute
Sur Gen'l for Oregon

Accepted by the Hon. Commissioner G. L. O. Feb 27 1909

Corners of

Courses	Ch^s Lk^s	Posts	Courses	Ch^s Lk^s	Posts	Courses	Ch^s Lk^s

Willamette Meridian.

Latitude 43° 0' N
Longitude 122° 51' W } 40 chs E of cor of Tps 29 & 30 S. Rgs 1 and 2 W.
Mean Mag Dec'l 21° 15' E

The above Map of Township No 29 South of Range No 1 West of the Willamette Meridian Oregon is strictly conformable to the field notes of the survey thereof on file in this Office, which have been examined and approved.

Surveyor Generals Office
Portland, Oregon June 29 1906 } Jno W Wale
Sur Gen'l for Oregon.

JW.