TOWNSHIP 29 SOUTH, RANGE 2 WEST, OF THE WILLAMETTE MERIDIAN, OREGON

DEPENDENT RESURVEY AND SUBDIVISION OF SECTION 15

FILED
Date: 4/4/2022 By: JC
This survey consists of:
Map: T29-2W 2021-1
Line VOL. 59
Notes: PGS 23933-23943

DOUGLAS COUNTY
SURVEYOR

OFFICIALLY FILED: 1/14/2022

A history of surveys, corner descriptions, and other relevant information are contained in the field notes.

This plat represents the dependent resurvey of a portion of the north boundary and subdivisional lines, designed to restore the corners in their true original locations according to the best available evidence, and the subdivision of section 15, Township 29 South, Range 2 West, Willamette Meridian, Oregon.

Official areas based on the measurements of this survey have been returned for Federal interest land where indicated. Aliquot part legal subdivisions retain their aliquot characteristics and refer to precisely the same land as that which was previously identified by its original survey or description. A lot can only be subdivided by survey or supplemental plat. Except as indicated hereon, the lottings and areas are as shown on the plat approved June 10, 1918.

Survey executed by Joseph M. Mannix and Justin V. Haddon, Cadastral Surveyors, beginning October 15, 2019, and completed November 20, 2019, pursuant to special instructions approved October 2, 2019, for Group No. 2957, Oregon.

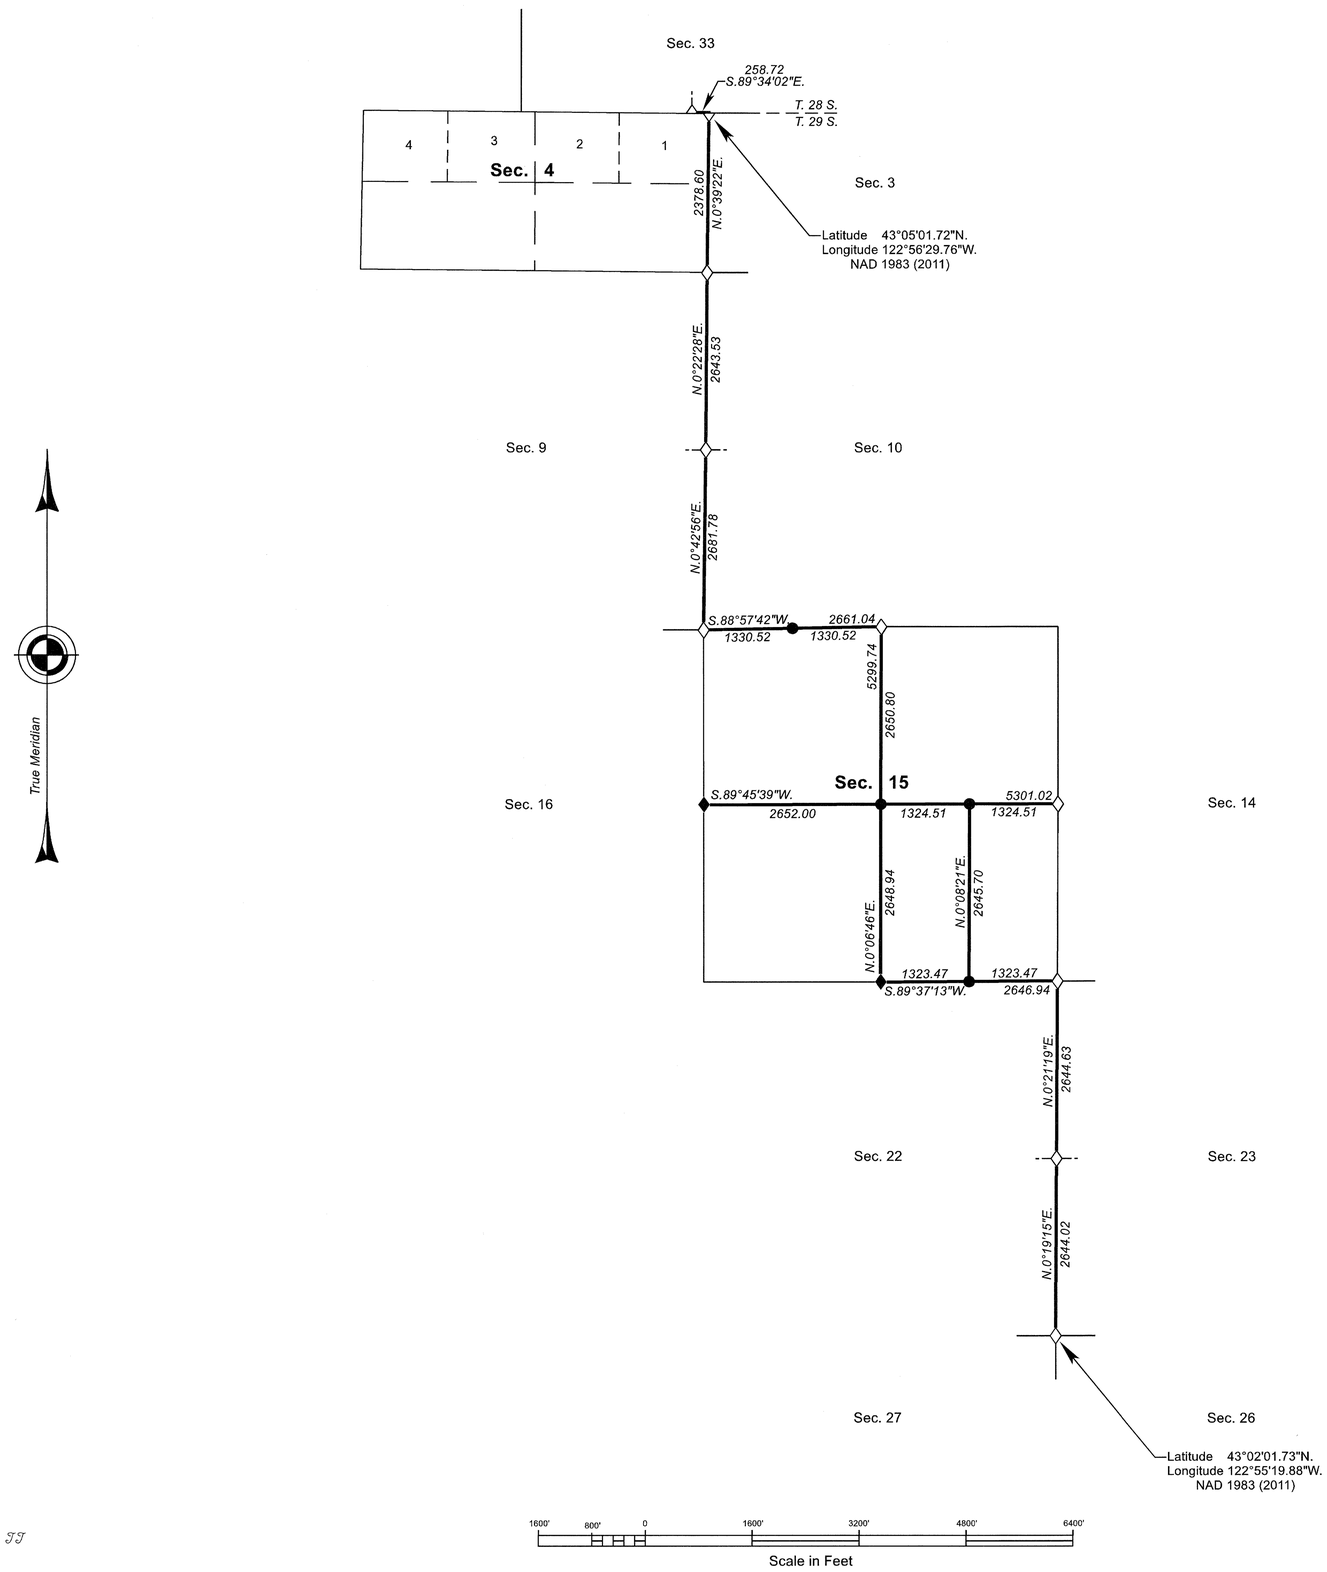

LEGAL SUBDIVISION	OFFICIAL ACRES
SECTION 15	
W1/2 SE1/4	80.46
TOTAL AREA 80.46 FEDERAL INTEREST LAND RESURVEYED	

LEGEND

- ◇ Original corner
- ◆ Original corner remonumented this survey
- ● Corner established this survey

UNITED STATES DEPARTMENT OF THE INTERIOR
BUREAU OF LAND MANAGEMENT

Portland, Oregon

This plat is strictly conformable to the approved field notes, and the survey, having been correctly executed in accordance with the requirements of law and the regulations of this Bureau, is hereby accepted.

For the Director

Mary J. M. Hartel

Chief Cadastral Surveyor of Oregon

September 14, 2021

Date

JJ