TOWNSHIP 29 SOUTH, RANGE 3 WEST, OF THE WILLAMETTE MERIDIAN, OREGON

DEPENDENT RESURVEY AND SUBDIVISION OF SECTION 23

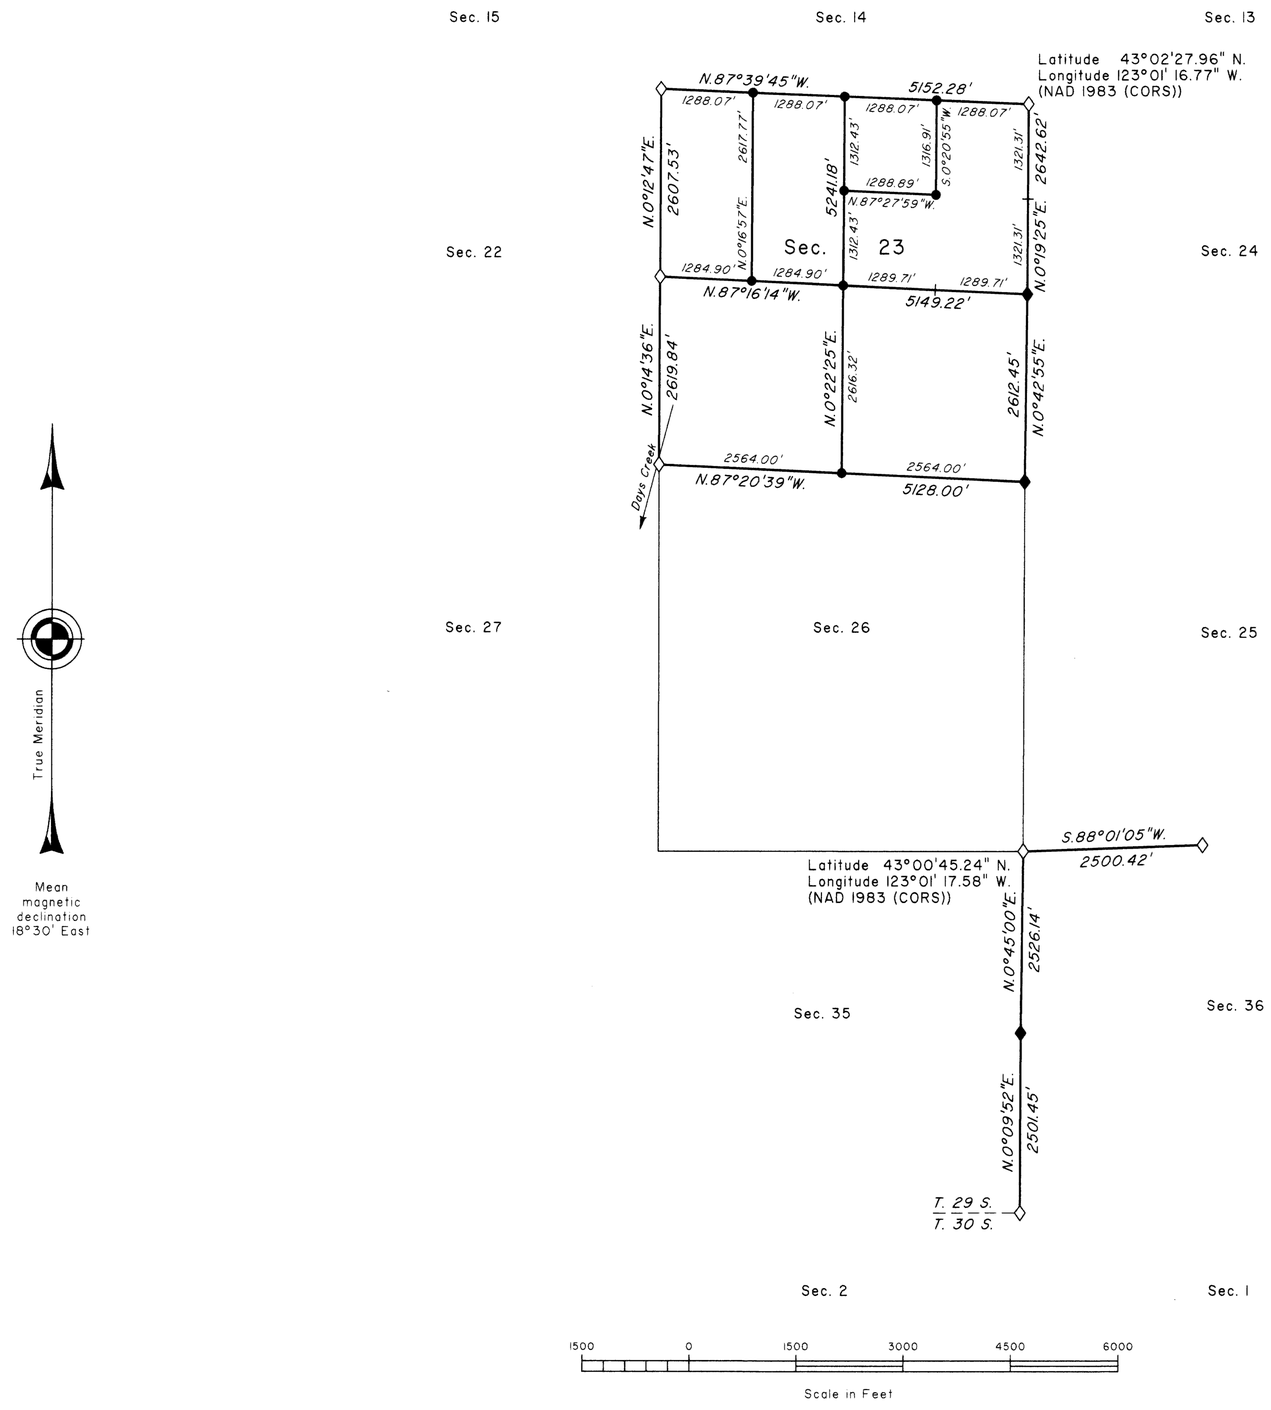

A history of surveys is contained in the field notes.

This plat represents a dependent resurvey of a portion of the subdivisional lines, T. 29 S., R. 3 W., Willamette Meridian, Oregon, designed to restore the corners in their true original locations according to the best available evidence, and the subdivision of section 23.

Measured distances and directions have been adjusted by Cadastral Measurement Management for Windows (WinCMM), computer software that incorporates a least squares adjustment routine. The adjusted bearings and distances are reported to the nearest second and 0.01 foot.

The lottings and areas are as shown on the plat approved August 11, 1881.

The survey was executed by Timothy J. Moore and A. Bert Skeesick, Cadastral Surveyors, beginning September 27, 2002, and completed June 23, 2003, pursuant to Special Instructions dated September 19, 2002, under Group Number 2033, Oregon.

Timber in this area consists of fir, cedar, maple, madrone, pine, chinquapin, and oak.

LEGEND

- ◇ Original corner previously remonumented
- ◆ Original corner remonumented this survey
- ● Corner established or reestablished this survey

UNITED STATES DEPARTMENT OF THE INTERIOR
BUREAU OF LAND MANAGEMENT

Portland, Oregon March 7, 2006

This plat is strictly conformable to the approved field notes, and the survey, having been correctly executed in accordance with the requirements of law and the regulations of this Bureau, is hereby accepted.

For the Director

John P. Farnsworth, Acting
Chief Cadastral Surveyor of Oregon

LEP