Township No. 29 South Range No. 4 West of the Willamette Meridian Oregon

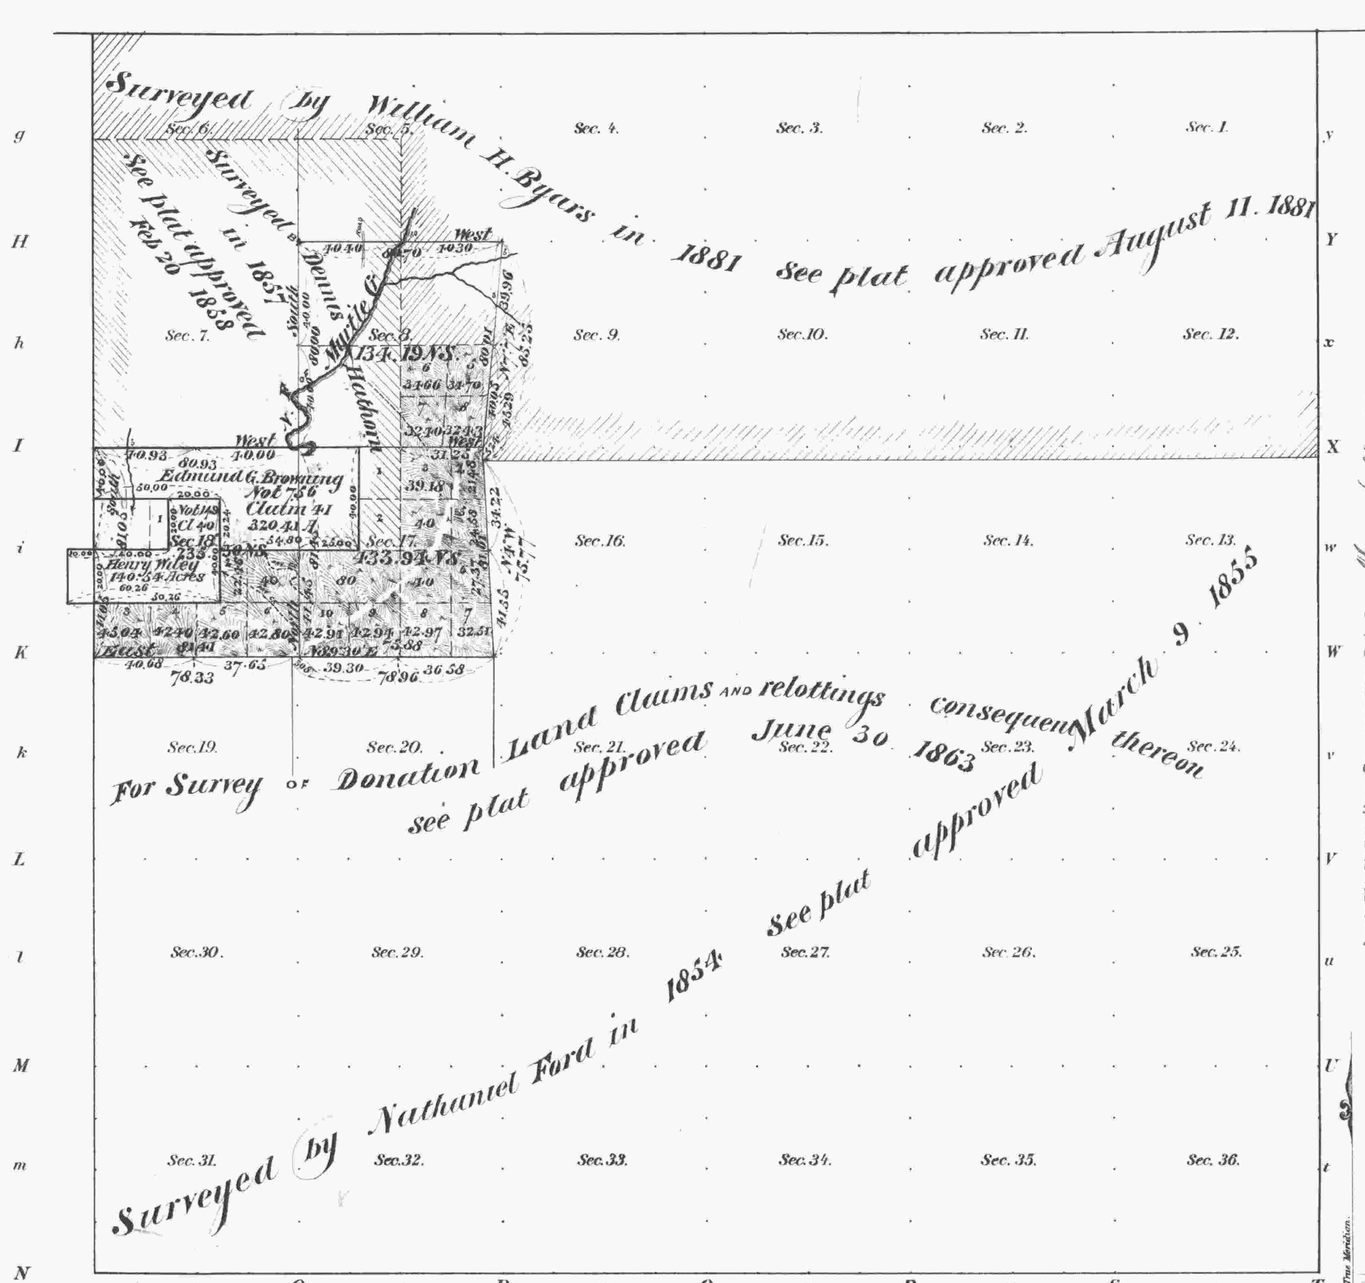

Area of Former Surveys 21669.27 Acres of New Survey 803.43 Acres — of that part Henry Wiley Donation Land Claim lying in the S½ of Sec 18 99.78 Acres Total number of Acres 22572.48

Latitude 43°03' N
Longitude 123°10' W
Mean Mag dec'l 18°45' E
} At ¼ sec cor bet Sec 8 and 17

Scale 40 Chains to an Inch.

Surveys Designated	By Whom Surveyed	Date of Contract	Amount of Surveys M.	Ch.s	Lk.s	When Surveyed	Contract
Township lines							
Subdivisions	William F. Briggs	January 18. 1899		72	70	April 13 to 16. 1899	Special Instructions
Connections	" " "	" " "		8	32	" " "	" "
Relocements	" " "	" " "	8	00	99	" " "	" "
South East and West Bdy of Twp	Nathaniel Ford	May 30 1854				1854	44
North " " "	William H Byars	Jany 22. 1881				1881	376

The above Map of Township No. 29 South of Range No. 4 West of the Willamette Meridian Oregon is strictly conformable to the field notes of the survey thereof on file in this Office, which have been examined and approved.

Surveyor Generals Office,
Portland, Oregon Oct 28. 1899

Robert A. Habersham
Sur. Gen.l for Oregon

J W