TOWNSHIP 29 SOUTH, RANGE 5 WEST, OF THE WILLAMETTE MERIDIAN, OREGON

METES AND BOUNDS SURVEY

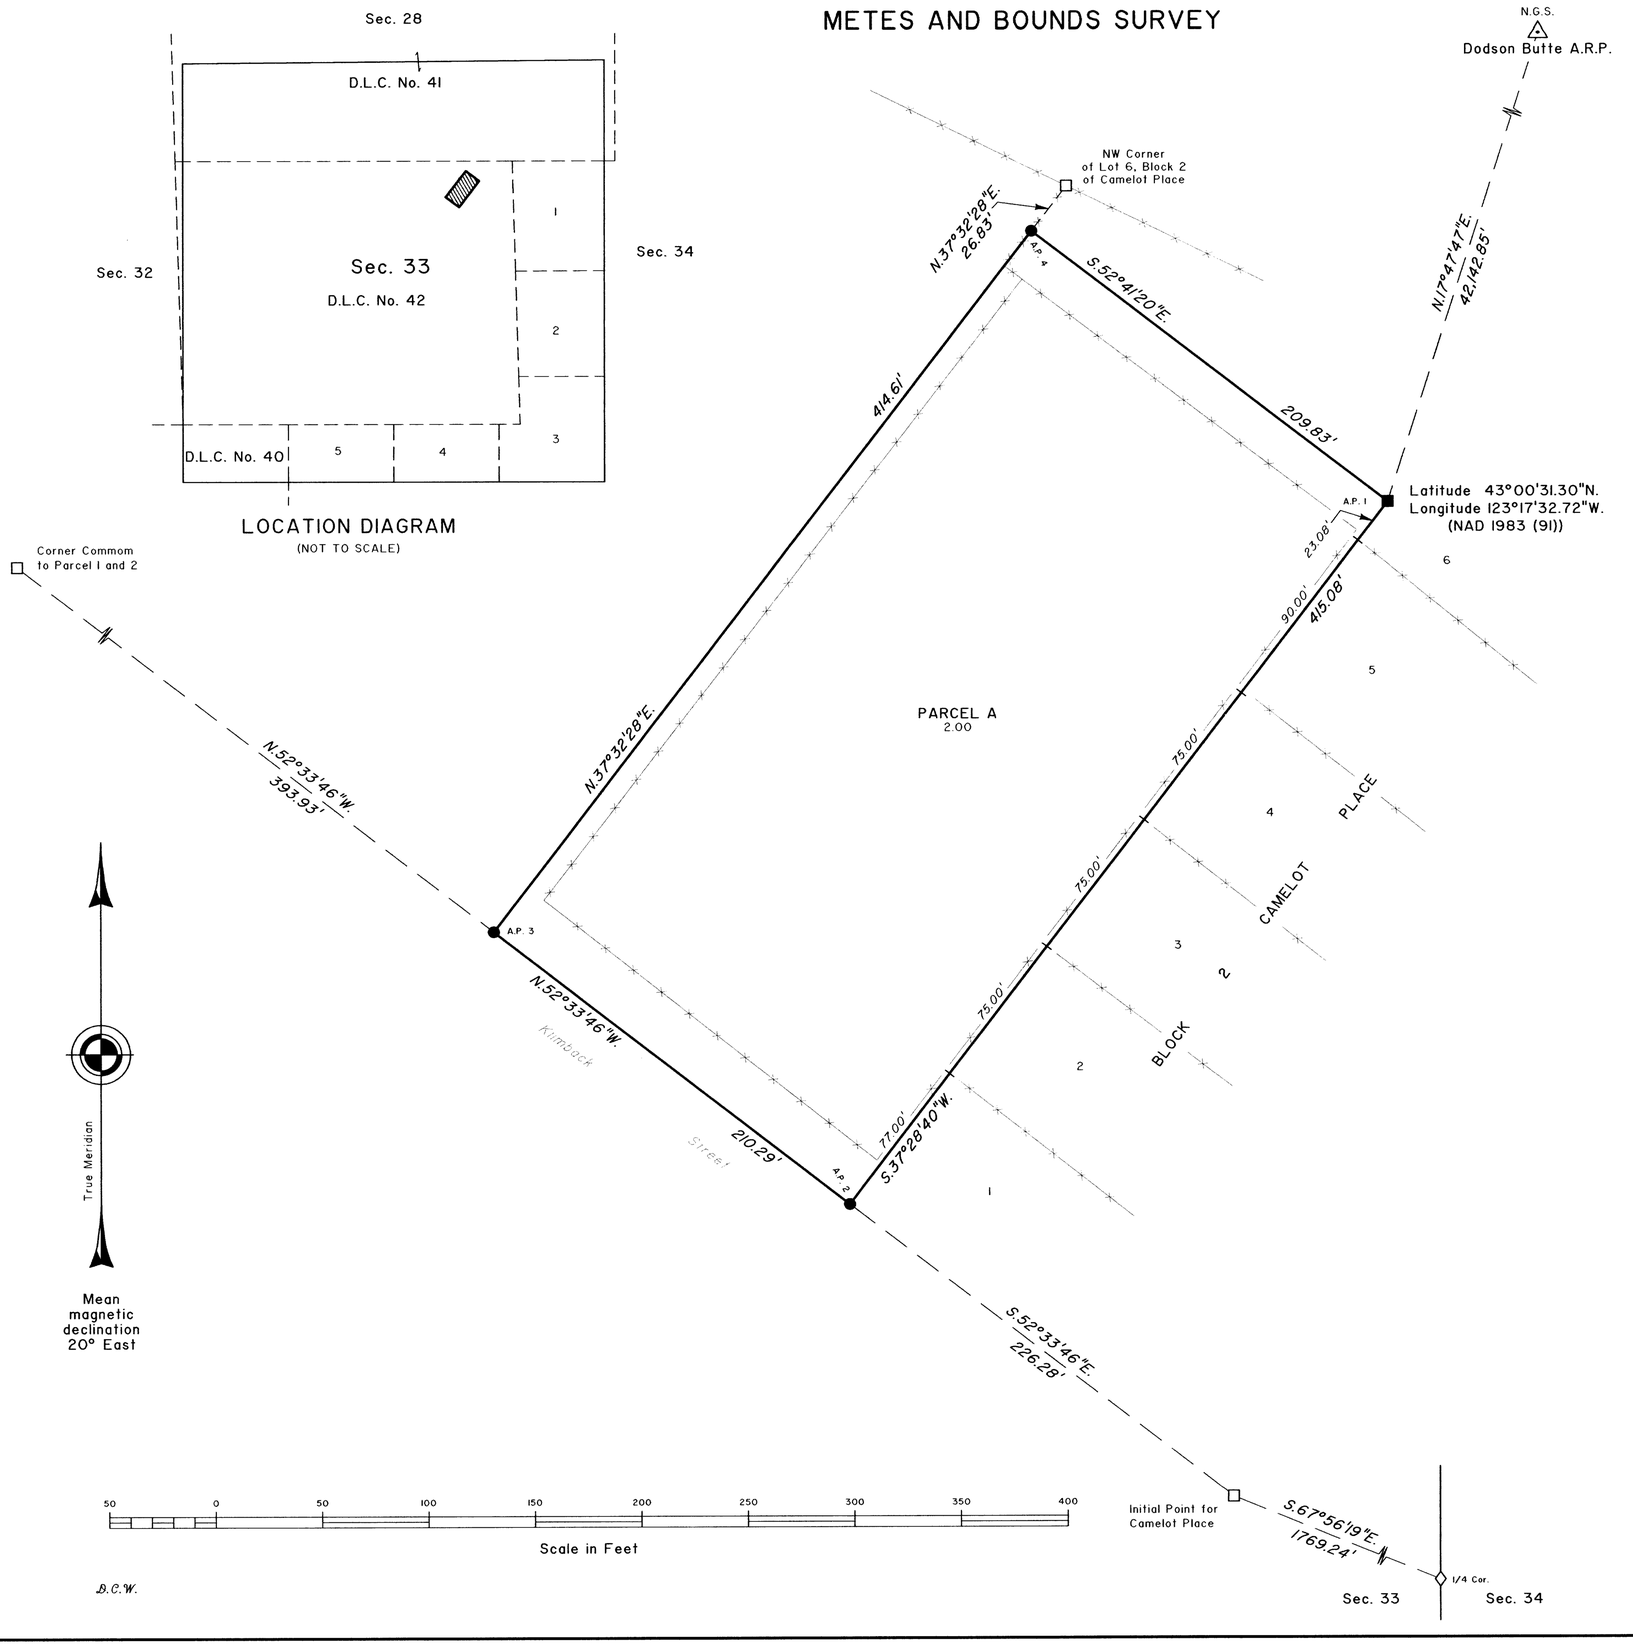

A history of surveys is contained in the field notes.

This plat represents a metes-and-bounds survey of Parcel A in the NE 1/4 of Section 33, T. 29 S., R. 5 W., Willamette Meridian, Oregon.

Measured distances and directions have been adjusted by Cadastral Measurement Management (CMM), computer software that incorporates a least squares adjustment routine. The adjusted bearings and distances are reported to the nearest second and 0.01 foot.

The area of Parcel A is as shown on the plat.

The survey was executed by Timothy J. Moore, Cadastral Surveyor, beginning September 16, 2002, and completed October 9, 2002, pursuant to Special Instructions dated May 28, 2002, under Group Number 2015, Oregon.

There is no timber in this area.

The tie to the geodetic control station is reported as mean bearing and sea level distance.

LEGEND

- ◇ Original corner previously remonumented
- □ Corner previously established or reestablished
- ■ Corner previously established or reestablished; remonumented this survey
- ● Corner established or reestablished this survey
- Fence line

UNITED STATES DEPARTMENT OF THE INTERIOR
BUREAU OF LAND MANAGEMENT

Portland, Oregon October 31, 2003

This plat is strictly conformable to the approved field notes, and the survey, having been correctly executed in accordance with the requirements of law and the regulations of this Bureau, is hereby accepted.

For the Director

John P. Beaudoreth, Acting

Chief Cadastral Surveyor of Oregon