TOWNSHIP 29 SOUTH, RANGE 5 EAST, OF THE WILLAMETTE MERIDIAN, OREGON

DEPENDENT RESURVEY, SUBDIVISION OF SECTIONS 4, 5 AND 8, AND SURVEY

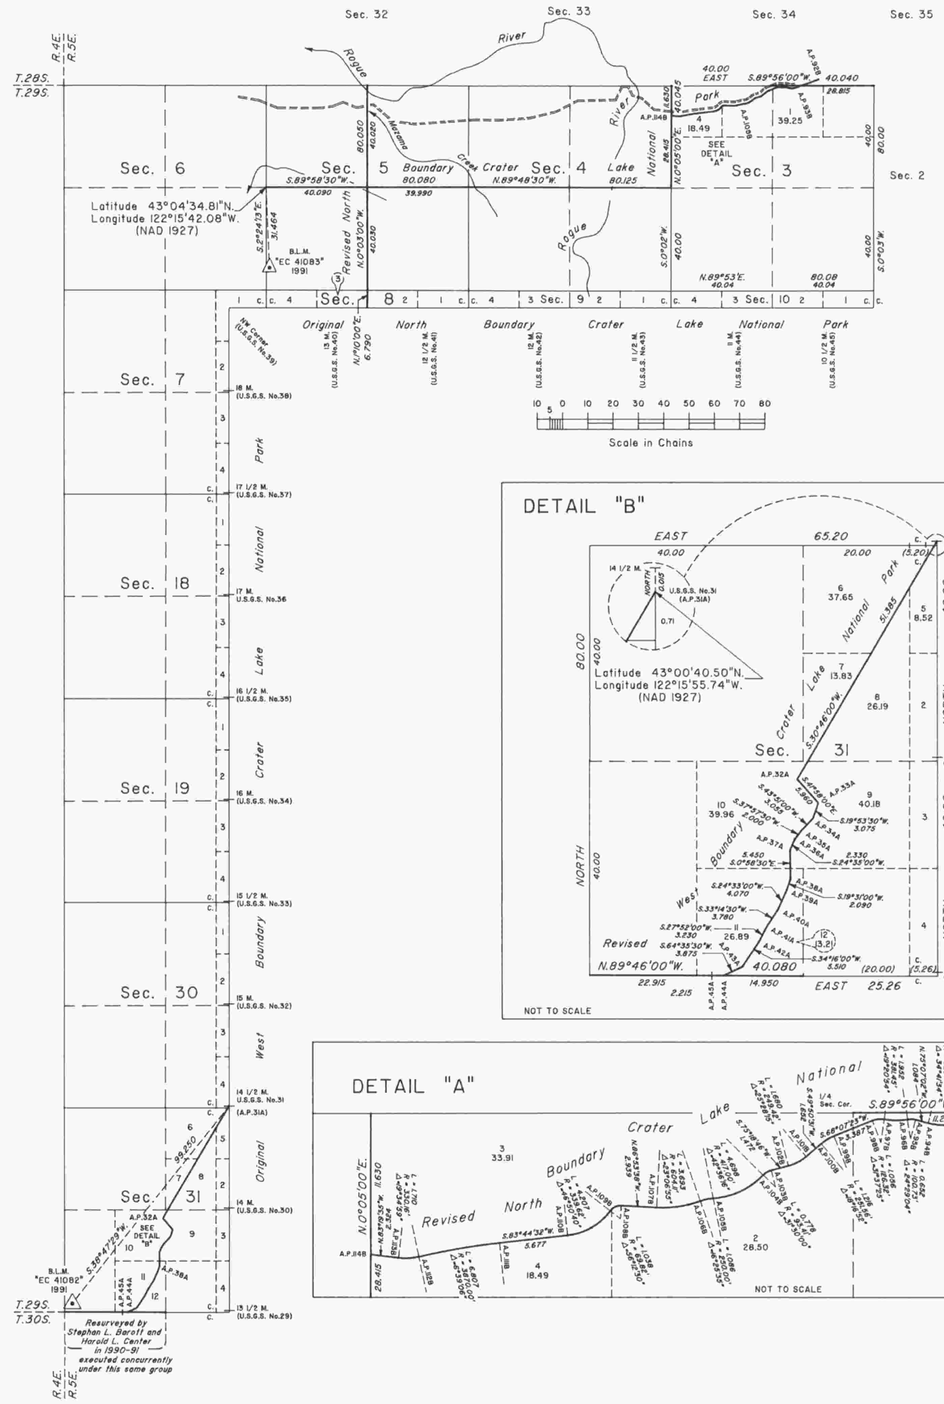

A history of surveys is contained in the field notes.

This plat represents a dependent resurvey of a portion of the north boundary and subdivisional lines, T. 29 S., R. 5 E., Willamette Meridian, Oregon, designed to restore the corners in their true original locations according to the best available evidence, the subdivision of sections 4, 5 and 8, and the survey of the metes-and-bounds portion of the Revised North and West Boundaries of Crater Lake National Park.

Except as shown hereon, the lottings and areas are as shown on the plat approved October 6, 1931.

The survey was executed by Daniel E. Weller, Stephan L Barott, and Harold L. Center, Cadastral Surveyors, beginning September 14, 1990, and completed July 22, 1992, pursuant to Special Instructions dated September 11, 1990, under Group Number 1571, Oregon.

Timber in this area is primarily fir.

The lightweight lines were surveyed or resurveyed by Herbert N. Raymond in 1930.

The tie to the geodetic control station is reported as mean bearing and sea level distance.

UNITED STATES DEPARTMENT OF THE INTERIOR
BUREAU OF LAND MANAGEMENT

Portland, Oregon June 30, 1995

This plat is strictly conformable to the approved field notes, and the survey, having been correctly executed in accordance with the requirements of law and the regulations of this Bureau, is hereby accepted.

For the Director

Wayne M. Gardner

Chief Cadastral Surveyor of Oregon

R.F.B.