5518

ORIGINAL

TOWNSHIP 29 SOUTH, RANGE 6 WEST, OF THE WILLAMETTE MERIDIAN, OREGON.

DEPENDENT RESURVEY AND SUBDIVISION OF SECTION 15

Sec. 4 | Sec. 3

Sec. 9 | Sec. 10 | Sec. 11

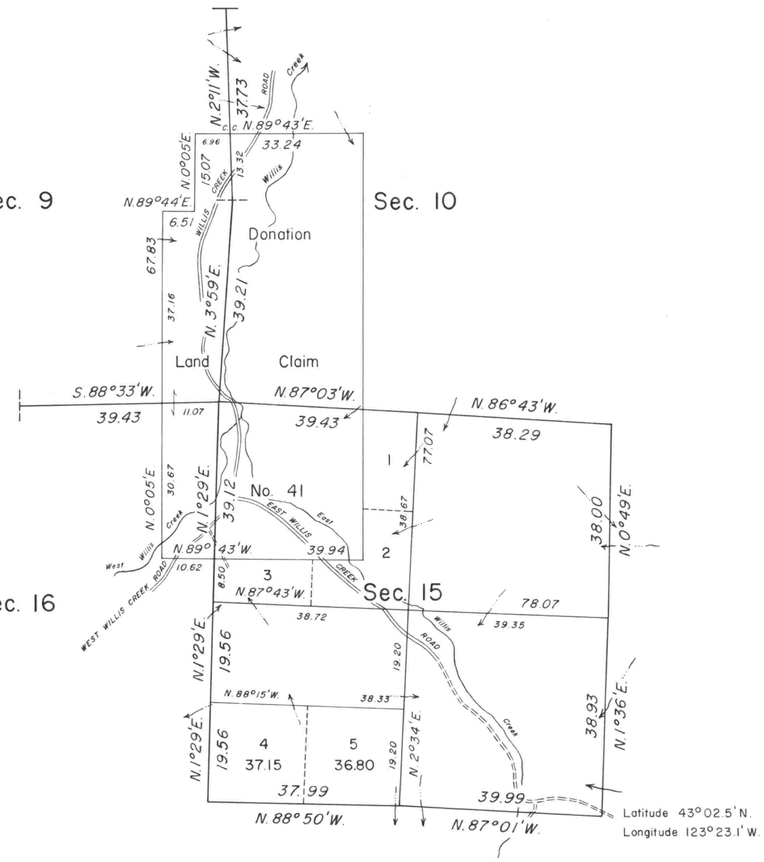

Sec. 14

Sec. 21 | Sec. 22 | Sec. 23

Mean
Magnetic
Declination
19° 45' E.

Chains

Timber in this area consists of fir, cedar, hemlock, oak, myrtle, and maple.

This plat represents a retracement and reestablishment of a portion of the subdivisional lines and a portion of the claim lines of Donation Land Claim No. 41, T. 29 S., R. 6 W., Willamette Meridian, Oregon, designed to restore all the corners in their true original location according to the best available evidence; and the subdivision of section 15.

Excepting as new or modified vacant subdivisions are shown hereon, the lottings and areas are as shown on the plats approved March 9, 1855, and June 30, 1863.

A portion of the subdivisional lines in the township were surveyed by Nathaniel Ford in 1854. The boundaries of the Donation Land Claims in the township were surveyed by Josiah A. Burnette in 1860.

The resurvey and subdivision of section 15 were executed by Peter A. Peterson and Daniel L. Berry, Cadastral Surveyors, from July 26, 1971 to August 26, 1971, under Special Instructions dated July 7, 1971, which provide for the surveys included under Group No. 750, Oregon.

UNITED STATES DEPARTMENT OF THE INTERIOR
BUREAU OF LAND MANAGEMENT
Washington, D.C. April 5, 1974

This plat is strictly conformable to the approved field notes, and the survey, having been correctly executed in accordance with the requirements of law and the regulations of this Bureau, is hereby accepted.

For the Director

Mark I. Gumm

Chief, Division of Cadastral Survey

SWZ

CAR